RECEIVED
1 1957
STATE ENGINEER
SALEM, OREGON

REGISTRATION NO. GR 382
CERTIFICATE NO. GR 369

Registration Statement

OF CLAIMANT OF RIGHT TO APPROPRIATE GROUND WATER

(Under Chapter 708, Oregon Laws 1955.)

TO THE STATE ENGINEER OF OREGON:

I, David Blumenstein,

of Route 1, Box 210, Central Point County of Jackson

State of Oregon, do hereby make application for a certificate of registration as evidence of a right to appropriate ground water.

1. **Source** from which water is withdrawn is Infiltration trench (Flowing well, pump well, infiltration trench, or tunnel)

2. **Location** is: approximately 1 mile west of Central Point, Oregon (Approximate distance and direction from nearest city or town);

and is more particularly described as follows:

(a) 1040 feet North and 340 feet East from the W¼ corner Section 10 (Give distance and bearing to corner of section or other legal subdivision)

being within SW¼ NW¼ (Smallest legal subdivision) of Sec. 10, Twp. 37 S. (N. or S.), Rge. 2 W. (E. or W.)

or (b) within limits of recorded platted property, town or city:

in Lot ....., Block ..... of ..... (Name of plat or addition)

..... (If within city or town, give name) County of .....

3. **Construction Work** was begun on August 1950 (Date); was completed on August 1950 (Date)

and the ground water claimed was first used for the purposes set out below on May 1951 (Date),

since which time the water has been used continuously (Continuously or intermittently)

from May 1951 (Date) to date (Date)

4. **Quantity** of water claimed and used is 45 gallons per minute; 4.5 acre feet per year.

5. **Purpose or Purposes** for which water is used irrigation

..... (Domestic, irrigation, municipal, manufacturing, industrial, etc.)

6. **Description of Well:** Depth 18 feet. Type Dug (see item 11) (Dug or drilled)

diameter 20'x150' ~~inches~~. Elevation of ground at well site 1390 (As near as known) feet, mean sea level.

Depth to water table ..... feet.

7. **Capacity of Well:** ..... g.p.m. with ..... feet drawdown.

..... g.p.m. with ..... feet drawdown.

Date of test .....

If Flowing Well: Measured discharge ..... g.p.m. on ..... (Date)

Shut-in pressure at ground surface ..... lbs. per sq. in. on ..... (Date)

Water is controlled by ..... (Cap, valve, etc.)

8. **Casing:** (Give diameter, commercial specifications and depth below ground surface of each casing size.)

..... inch diameter ..... from ..... to ..... feet

..... inch diameter ..... from ..... to ..... feet

..... inch diameter ..... from ..... to ..... feet

..... inch diameter ..... from ..... to ..... feet

Describe and show depth of shoe, plug, adapter, liner or other details: .....

.....

.....

9. **Perforated Casings or Screens:**

..... from ..... to .....
(Number per foot and size of perforations, or describe screen)

..... from ..... to .....

..... from ..... to .....

..... from ..... to .....

10. **Log of Well:** (Describe each stratum or formation clearly; indicate if water bearing, and give thickness and depth as indicated.)

MATERIAL	Thickness (Feet)	Depth to Bottom (Feet)

If log of well is not available, give name and address of driller. .....

11. **Infiltration Trench:** Covered or open ....open....

Dimensions: Length ....150.... ft. Minimum depth ....0.... ft. Maximum depth ..18.... ft.

Bottom width ....12.... ft. Discharge ..... g.p.m. Date of test ....none....

12. **Tunnel:** Type of lining .....

Dimensions: .....
(Length, course, and cross sectional size)

Position of water bearing stratum with reference to portal of tunnel .....

Log of tunnel: (Preceding table for log of well may be used, if desired. Give footage from portal and character of materials, as pertinent.)

13. **Pumping Equipment:**

(a) Pump ....2.0 inch centrifugal pump.... Capacity ..60 (est.).. g.p.m.
(Make, type and size)

(b) Motor ....3.0 H.P. electric motor....
(Type and horsepower)

14. Location of area irrigated or to be irrigated, or place of use if for purposes other than irrigation.

Township North or South	Range E. or W. of Willamette Meridian	Section	Forty-acre Tract	Number Acres To Be Irrigated	Date of Reclamation
37 S.	2 W.	10	SW¼ NW¼	4.0 acres	May 1951

15. If the ground water supply is supplemental to an existing water supply, identification of any application for a permit, permit, certificate or adjudicated right to appropriate water made or held by the registrant.

This to be supplemental in part to Application No. 589, Permit No. 407.

Township 37 S Range 7 W, W.M.

North

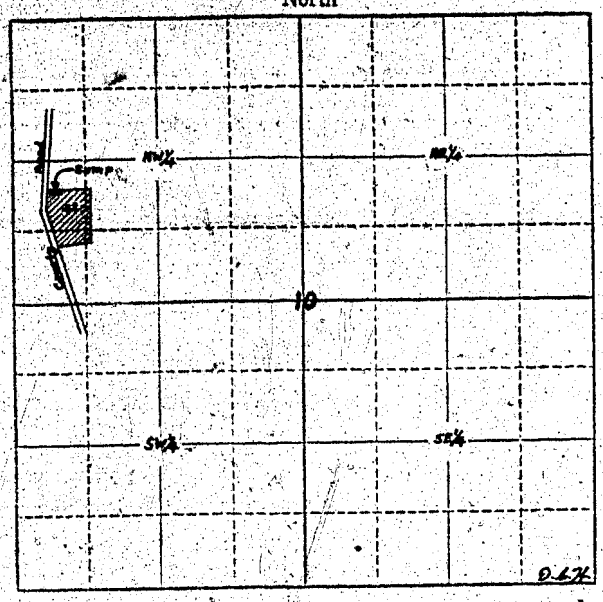

Locate well and acreage of irrigated land on plat.

Scale: 4" = 1 Mile

STATE OF OREGON
County of Jackson } ss.

I, David Blumenthal, being first duly sworn, do hereby certify that I have read the foregoing Registration Statement and that all of the items therein contained are true to the best of my knowledge and belief.

David Blumenthal
(Signature of Registrant)

Subscribed and sworn to before me this 28th day of February, 1957

My commission expires July 31- 1959

Edith Gault
(Notary Public)

(SEAL)

CERTIFICATE OF REGISTRATION

STATE OF OREGON
County of Marion } ss.

This is to certify that the foregoing Registration Statement was received in the office of the State Engineer on the 1st day of March, 1957, at 8:00 o'clock A M. and has been duly recorded in said office in Book No. 3 of Registration Statements on page GR-369 C

~~Construction shall be completed by X-X-X-X-X-X-X-X-X-19-X-X and the water completely applied to beneficial use by X-X-X-X-X-X-X-X-X-19-X-X~~

Witness my hand this 30th day of April, 1957

Lewis A. Stanley
(State Engineer)

$15.00

By
(Deputy)

GR 369 C