

Registration Statement

OF CLAIMANT OF RIGHT TO APPROPRIATE GROUND WATER

TO THE STATE ENGINEER OF OREGON:

I, Jesse V. Downer
 of 5005 Ridge Drive Salem County of Marion
(Mailing address)
 State of Oregon, do hereby make application for a certificate of registration as evidence
 of a right to appropriate ground water.

1. Source from which water is withdrawn is Pump well
(Flowing well, pump well, infiltration trench, or tunnel)
 2. Location is: 5 miles N. of Salem, Ore.
(Approximate distance and direction from nearest city or town)

and is more particularly described as follows:

(a) 375' N. and 220' E. of the SW Corner of NE 1/4 of NW 1/4
(Give distance and bearing to corner of section or other legal subdivision)
 being within NE 1/4 of NW 1/4 of Sec. 1, Twp. 7 S, Rge. 3 W
(Smallest legal subdivision) (N. or S.) (E. or W.)

or (b) within limits of recorded platted property, town or city:

in Lot _____, Block _____ of _____
(Name of plat or addition)
 _____ County of _____
(If within city or town, give name)

3. Construction Work was begun on July 3, 1951; was completed on July 20, 1951
(Date) (Date)
 and the ground water claimed was first used for the purposes set out below on August 1951
(Date)
 since which time the water has been used Intermittently
(Continuously or Intermittently)
 from July 1951 to July 1958
(Date) (Date)

4. Quantity of water claimed and used is 150 gallons per minute; 60 acre
 feet per year.

5. Purpose or Purposes for which water is used Irrigation

(Domestic, irrigation, municipal, manufacturing, industrial, etc.)

6. Description of Well: Depth 6.8 feet. Type Drilled
(Dug or drilled)
 diameter 10 inches. Elevation of ground at well site Not known feet, mean sea level.
(As near as known)
 Depth to water table 4 feet.

7. Capacity of Well: Unknown g.p.m. with _____ feet drawdown.
 _____ g.p.m. with _____ feet drawdown.

Date of test No Test

If Flowing Well: Measured discharge _____ g.p.m. on _____
(Date)

Shut-in pressure at ground surface _____ lbs. per sq. in. on _____
(Date)

Water is controlled by _____
(Cap, valve, etc.)

10 inch diameter from 0 to 48 feet
inch diameter from to feet
inch diameter from to feet
inch diameter from to 5 feet

Describe and show depth of shoe, plug, adapter, liner or other details: _____


Unknown	from	to
(Number per foot and size of perforations, or describe screen)		
	from	to
	from	to
	from	to
	from	to

[illegible]

Rt. 1 Brooks, Ore.

- Position of water bearing stratum with reference to portal of tunnel

Township 75 Range 3w W.M.
North

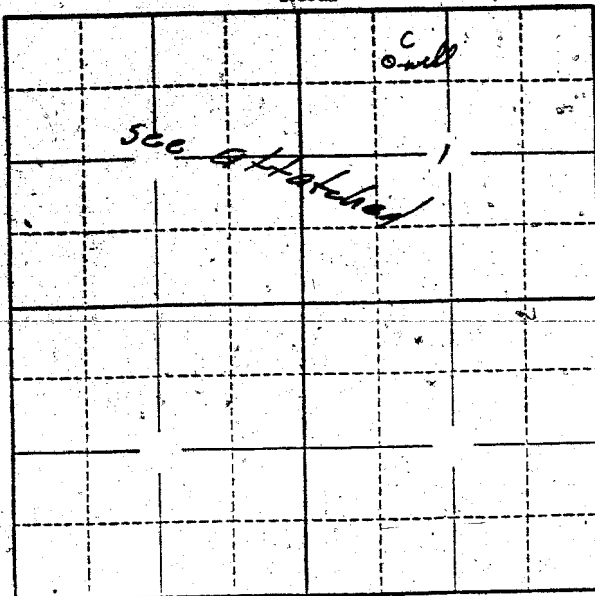

Locate well and acreage of irrigated land on plat.

Scale: 2" = 1 Mile

STATE OF OREGON

County of Marion

ss.

I, Jesse V. Downer, being first duly sworn, do hereby certify that I have read the foregoing Registration Statement and that all of the items therein contained are true to the best of my knowledge and belief.

Jesse V. Downer
(Signature of Registrant)

Subscribed and sworn to before me this 1st day of August, 1958

My commission expires 12th June 1961

Wm. S. Bartholomew
(Notary Public)

(SEAL)

CERTIFICATE OF REGISTRATION

STATE OF OREGON

County of Marion

ss.

This is to certify that the foregoing Registration Statement was received in the office of the State Engineer on the 1st day of August, 1958, at 4:45 o'clock P. M. and has been duly recorded in said office in Book No. 14 of Registration Statements on page GR-3484

Witness my hand this 15th day of September, 1959

B

\$15.00

Lewis A. Stanley
(State Engineer)

By

(Deputy)

GR 3484