

# Registration Statement

## OF CLAIMANT OF RIGHT TO APPROPRIATE GROUND WATER

TO THE STATE ENGINEER OF OREGON:

I, William Towery  
of Rt. 1 Box 151 Turner, Oregon County of Marion

State of Oregon, do hereby make application for a certificate of registration as evidence of a right to appropriate ground water.

1. Source from which water is withdrawn is pump well  
(Flowing well, pump well, infiltration trench, or tunnel)
2. Location is: 3 mi East of Marion  
(Approximate distance and direction from nearest city or town)

and is more particularly described as follows:

(a) 155' East and 860' South of NE Corner of NW 1/4 of NW 1/4  
(Give distance and bearing to corner of section or other legal subdivision)  
being within NE 1/4 of NW 1/4 of Sec. 25, Twp. 9S, Rge. 2W  
(Smallest legal subdivision) (N. or S.) (E. or W.)

(b) within limits of recorded platted property, town or city:

in Lot \_\_\_\_\_, Block \_\_\_\_\_ of \_\_\_\_\_  
(Name of plat or addition)  
County of Marion  
(If within city or town, give name)

3. Construction Work was begun on April 1949; was completed on April 1949  
(Date) (Date)  
and the ground water claimed was first used for the purposes set out below on May 1949  
(Date)  
since which time the water has been used through out the growing season  
(Continuously or intermittently)  
from Spring to Fall  
(Date) (Date)

4. Quantity of water claimed and used is 350 gallons per minute; \_\_\_\_\_ acre feet per year.

5. Purpose or Purposes for which water is used Irrigation  
(Domestic, irrigation, municipal, manufacturing, industrial, etc.)

6. Description of Well: Depth 21 feet. Type drilled  
(Dug or drilled)  
diameter 8 inches. Elevation of ground at well site 382 feet, mean sea level.  
(As near as known)  
Depth to water table 7 feet.

7. Capacity of Well: 450 g.p.m. with 3.5 feet drawdown.  
\_\_\_\_\_ g.p.m. with \_\_\_\_\_ feet drawdown.

Date of test April 1949

If Flowing Well: Measured discharge \_\_\_\_\_ g.p.m. on \_\_\_\_\_  
(Date)

Shut-in pressure at ground surface \_\_\_\_\_ lbs. per sq. in. on \_\_\_\_\_  
(Date)

Water is controlled by \_\_\_\_\_  
(Cap, valve, etc.)






Map in 61 3824

Township 9S Range 2W, W.M.

North

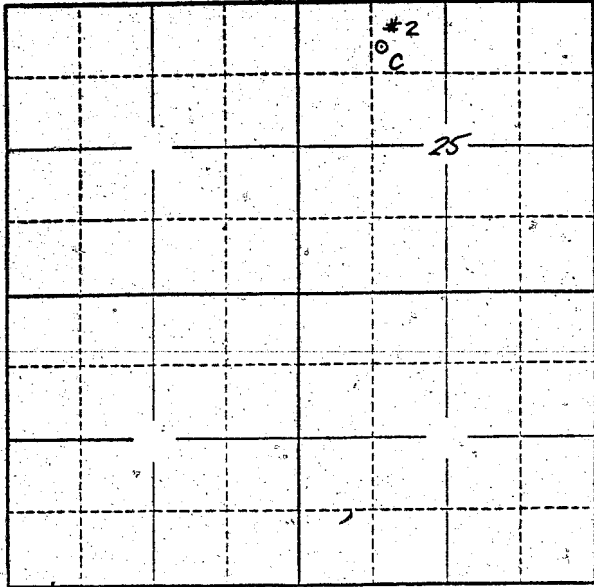

Locate well and acreage of irrigated land on plat.

Scale: 2" = 1 Mile

STATE OF OREGON

County of Marion } ss.

I, William Lowery, being first duly sworn, do hereby certify that I have read the foregoing Registration Statement and that all of the items therein contained are true to the best of my knowledge and belief.

William Lowery  
(Signature of Registrant)

Subscribed and sworn to before me this 31 day of July, 1958

My commission expires MY COMMISSION EXPIRES JAN. 19, 1962

J. H. Smith  
(Notary Public)

(SEAL)

**CERTIFICATE OF REGISTRATION**

STATE OF OREGON

County of Marion } ss.

This is to certify that the foregoing Registration Statement was received in the office of the State Engineer on the 1st day of August, 1958, at 4:45 o'clock P. M. and has been duly recorded in said office in Book No. 14 of Registration Statements on page GR-3486

Witness my hand this 15<sup>th</sup> day of September, 1959

Henry A. Stanley  
(State Engineer)

By \_\_\_\_\_ (Deputy)

\$15.00

GR 3486