

#4 SW of House

Registration No. GR 3827

Certificate No. GR 3488

Registration Statement

OF CLAIMANT OF RIGHT TO APPROPRIATE GROUND WATER

TO THE STATE ENGINEER OF OREGON:

I, William Towerly
of Box 151 ; Turner, Ore County of Marion
(Mailing address)

State of Oregon, do hereby make application for a certificate of registration as evidence of a right to appropriate ground water.

1. Source from which water is withdrawn is pump well #4
(Flowing well, pump well, infiltration trench, or tunnel)

2. Location is: 3 mi East of Marion
(Approximate distance and direction from nearest city or town)

and is more particularly described as follows:

(a) 155' East and 742' North of N.E. corner of SW 1/4 of SW 1/4
(Give distance and bearing to corner of section or other legal subdivision)

being within NE 1/4 of SW 1/4 of Sec. 25, Twp. 9S, Rge. 2W
(Smallest legal subdivision) (N. or S.) (E. or W.)

or (b) within limits of recorded platted property, town or city: _____

in Lot _____, Block _____ of _____
(Name of plat or addition)

County of Marion
(If within city or town, give name)

3. Construction Work was begun on April 1942; was completed on April 1942
(Date) (Date)

and the ground water claimed was first used for the purposes set out below on May 1942
(Date)

since which time the water has been used throughout the growing season
(Continuously or intermittently)

from Spring to fall
(Date) (Date)

4. Quantity of water claimed and used is 350 gallons per minute; _____ acre feet per year.

5. Purpose or Purposes for which water is used irrigation

(Domestic, irrigation, municipal, manufacturing, industrial, etc.)

6. Description of Well: Depth 26 feet. Type drilled
(Dug or drilled)

diameter 8 inches. Elevation of ground at well site 382 feet, mean sea level.
(As near as known)

Depth to water table 9 feet.

7. Capacity of Well: 450 g.p.m. with 2.5 feet drawdown.

_____ g.p.m. with _____ feet drawdown.

Date of test April 1942

If Flowing Well: Measured discharge _____ g.p.m. on _____
(Date)

Shut-in pressure at ground surface _____ lbs. per sq. in. on _____
(Date)

Water is controlled by _____
(Cap, valve, etc.)

8. Casing: (Give diameter, commercial specifications and depth below ground surface of each casing size.)

8 inch diameter from 0 to 26 feet
 inch diameter / from to feet
 inch diameter from to 5 feet
 inch diameter from to feet

Describe and show depth of shoe, plug, adapter, liner or other details: _____

9. Perforated Casings or Screens:

3 - 3/8" x 6" per foot from 10 to 26
(Number per foot and size of perforations, or describe screen)

from to
 from to
 from to

10. Log of Well: (Describe each stratum or formation clearly, indicate if water bearing, and give thickness and depth as indicated.)

MATERIAL	Thickness (Feet)	Depth to Bottom (Feet)
Sub soil	6	6
Sand and gravel	5	11
Water gravel	15	26

If log of well is not available, give name and address of driller.

11. Infiltration Trench: Covered or open

Dimensions: Length ft. Minimum depth ft. Maximum depth ft.

Bottom width ft. Discharge g.p.m. Date of test

12. Tunnel: Type of lining

Dimensions:
(Length, course, and cross sectional size)

Position of water bearing stratum with reference to portal of tunnel

Log of tunnel: (Preceding table for log of well may be used, if desired. Give footage from portal and character of materials, as pertinent.)

13. Pumping Equipment:

(a) Pump Fairbanks-Morse Centrifugal 3" Capacity 350 g.p.m.
(Make, type and size)

(b) Motor 3 1/2 15 hp.
(Type and horsepower)


14. Location of area irrigated or to be irrigated, or place of use if for purposes other than irrigation.

Township North or South	Range E. or W. of Willamette Meridian	Section	Forty-acre Tract	Number Acres To Be Irrigated	Date of Reclamation
9S	2W	25	NE 1/4 of SW 1/4	11.4	May 1942

15. If the ground water supply is supplemental to an existing water supply, identification of any application for a permit, permit, certificate or adjudicated right to appropriate water made or held by the registrant.

Map in GR 3824

Township 9S Range 2W, W.M.
North

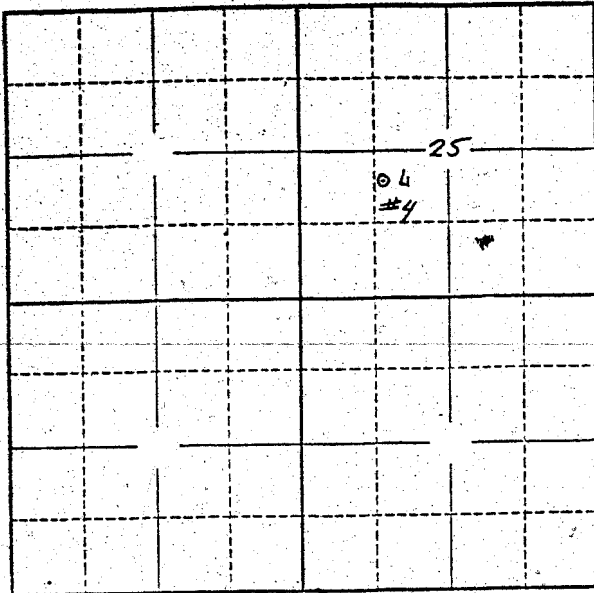

Locate well and acreage of irrigated land on plat.

Scale: 2" = 1 Mile

STATE OF OREGON

County of Marion } ss.

I, William Towery, being first duly sworn, do hereby certify that I have read the foregoing Registration Statement and that all of the items therein contained are true to the best of my knowledge and belief.

William Towery
(Signature of Registrant)

Subscribed and sworn to before me this 31 day of July, 1958

My commission expires MY COMMISSION EXPIRES JAN. 19, 1962

J. H. Smith
(Notary Public)

(SEAL)

CERTIFICATE OF REGISTRATION

STATE OF OREGON } ss.
County of Marion

This is to certify that the foregoing Registration Statement was received in the office of the State Engineer on the 1st day of August, 1958, at 4:45 o'clock P. M. and has been duly recorded in said office in Book No. 14 of Registration Statements on page GR 3488

Witness my hand this 15th day of September, 1959

Laura A. Stanley
(State Engineer)

\$15.00

By _____
(Deputy)

GR 3488