

#5 SE of House

Registration No. GR 3828

Certificate No. GR 3489

Registration Statement

OF CLAIMANT OF RIGHT TO APPROPRIATE GROUND WATER

TO THE STATE ENGINEER OF OREGON:

I, William Towery
of P.O. Box 151; Turner, Oregon County of Marion

State of _____, do hereby make application for a certificate of registration as evidence of a right to appropriate ground water.

- 1. Source from which water is withdrawn is pump well #5
(Flowing well, pump well, infiltration trench, or tunnel)
- 2. Location is: 3 mi East of Marion
(Approximate distance and direction from nearest city or town)

and is more particularly described as follows:

(a) 289' W and 700' South of NE Corner of NE 1/4 of NW 1/4
(Give distance and bearing to corner of section or other legal subdivision)
being within NE 1/4 of NW 1/4 of Sec. 25, Twp. 9S, Rge. 2W
(Smallest legal subdivision) (N. or S.) (E. or W.)

or (b) within limits of recorded platted property, town or city:

in Lot _____, Block _____ of _____
(Name of plat or addition)
County of Marion
(If within city or town, give name)

3. Construction Work was begun on April 1947; was completed on April 1947
(Date) (Date)

and the ground water claimed was first used for the purposes set out below on May 1947
(Date)
since which time the water has been used throughout the growing season
(Continuously or intermittently)
from Spring to Fall
(Date) (Date)

4. Quantity of water claimed and used is 350 gallons per minute; _____ acre feet per year.

5. Purpose or Purposes for which water is used irrigation

(Domestic, irrigation, municipal, manufacturing, industrial, etc.)

6. Description of Well: Depth 21 feet. Type drilled
(Dug or drilled)
diameter 8 inches. Elevation of ground at well site 382 feet, mean sea level.
(As near as known)
Depth to water table 9 feet.

7. Capacity of Well: 450 g.p.m. with 2.5 feet drawdown.
_____ g.p.m. with _____ feet drawdown.

Date of test April 1947


If Flowing Well: Measured discharge _____ g.p.m. on _____
(Date)

Shut-in pressure at ground surface _____ lbs. per sq. in. on _____
(Date)

Water is controlled by _____
(Cap, valve, etc.)

Map in Gr 3824

Township 9S Range 2W, W.M.
North

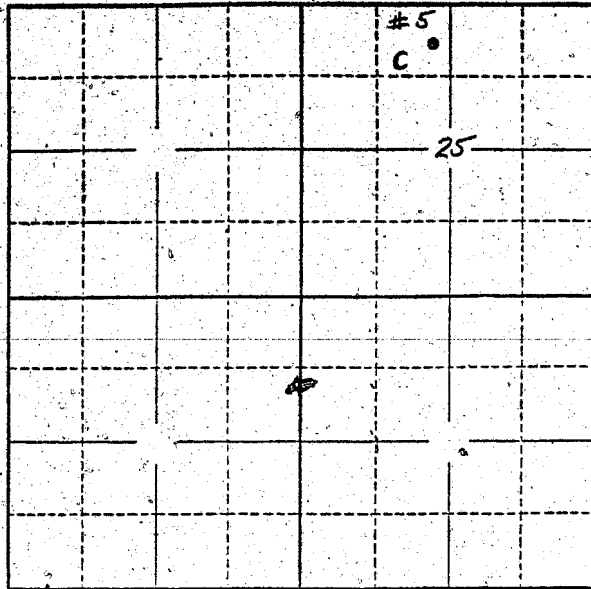

Locate well and acreage of irrigated land on plat.

Scale: 2" = 1 Mile

STATE OF OREGON

County of Marion } ss.

I, William Towery, being first duly sworn, do hereby certify that I have read the foregoing Registration Statement and that all of the items therein contained are true to the best of my knowledge and belief.

William Towery
(Signature of Registrant)

Subscribed and sworn to before me this 31 day of July, 1958

My commission expires MY COMMISSION EXPIRES JAN. 19, 1952

J. W. South
(Notary Public)

(SEAL)

CERTIFICATE OF REGISTRATION

STATE OF OREGON }
County of Marion } ss.

This is to certify that the foregoing Registration Statement was received in the office of the State Engineer on the 1st day of August, 1958, at 4:45 o'clock P.M. and has been duly recorded in said office in Book No. 14 of Registration Statements on page GR-3489

Witness my hand this 15th day of September, 1959

Russ A. Stanley
(State Engineer)

By _____ (Deputy)

\$15.00

GR 3489