

REGISTRATION NO. GR-383

Registration Statement

CERTIFICATE NO. 67 370

OF CLAIMANT OF RIGHT TO APPROPRIATE GROUND WATER

(Under Chapter 768, Oregon Laws 1955.)

TO THE STATE ENGINEER OF OREGON:

I, Herman Howard RT 2, Box 387
of Esposon Osa County of Lane
State of Oregon, do hereby make application for a certificate of registration as evidence of a right to appropriate ground water:

1. Source from which water is withdrawn is Pump Wells
(Flowing well, pump well, infiltration trench, or tunnel)

2. Location is: _____
(Approximate distance and direction from nearest city or town)

and is more particularly described as follows:

(a) 600 feet North and 900 feet West from E 1/4 corner of section 31
(Give distance and bearing to corner of section or other legal subdivision)

being within SE 1/4 of NE 1/4 of Sec. 31, Twp. 16 S, Rge. 3 W
(Smallest legal subdivision) (N. or S.) (E. or W.)

or (b) within limits of recorded platted property, town or city: _____

in Lot _____, Block _____ of _____
(Name of plat or addition)

_____ County of _____
(If within city or town, give name)

3. Construction Work was begun on 1943; was completed on 1943
(Date) (Date)

and the ground water claimed was first used for the purposes set out below on 1943
(Date)

since which time the water has been used cont. during summer
(Continuously or intermittently)

from 1943 to 1954
(Date) (Date)

4. Quantity of water claimed and used is 280 gallons per minute; _____ acre feet per year.

5. Purpose or Purposes for which water is used Irrigation
(Domestic, irrigation, municipal, manufacturing, industrial, etc.)

6. Description of Well: Depth 20 feet. Type Drum
(Dug or drilled)

diameter 3-2 pipe inches. Elevation of ground at well site 380 feet, mean sea level.
(As near as known)

Depth to water table 12 feet.

7. Capacity of Well: _____ g.p.m. with _____ feet drawdown.

_____ g.p.m. with _____ feet drawdown.

Date of test _____

If Flowing Well: Measured discharge _____ g.p.m. on _____ (Date)

Shut-in pressure at ground surface _____ lbs. per sq. in. on _____ (Date)

Water is controlled by _____
(Cap, valve, etc.)

8. Casing: (Give diameter, commercial specifications and depth below ground surface of each casing size.)

3-2 inch diameter *Pipes* from 0 to 20 feet
 inch diameter from to feet
 inch diameter from to feet
 inch diameter from to feet

Describe and show depth of shoe, plug, adapter, liner or other details:

9. Perforated Casings or Screens:

Dynamite from to
(Number per foot and size of perforations, or describe screen)
 from to
 from to
 from to


10. Log of Well: (Describe each stratum or formation clearly, indicate if water bearing, and give thickness and depth as indicated.)

MATERIAL	Thickness (Feet)	Depth to Bottom (Feet)
<i>Top Soil</i>	<i>4'</i>	<i>16'</i>
<i>Lower Gravel. Top by sand loam</i>	<i>16'</i>	<i>0</i>

more particularly described as follows, to-wit:

Beginning at a point 505.3' West of a point 1404.6' South of the corner common to sections 29, 30, 31 and 32 township 16 South Range 3 West of the Willamette Meridian and running thence West 695.2'; thence South 1195.4' to the North line of an open roadway thence East 695.2' and thence North 1195.4' to the place of beginning, containing 19.10 acres more or less in Lane County, Oregon.

Township 16S Range 3W W.M.
North

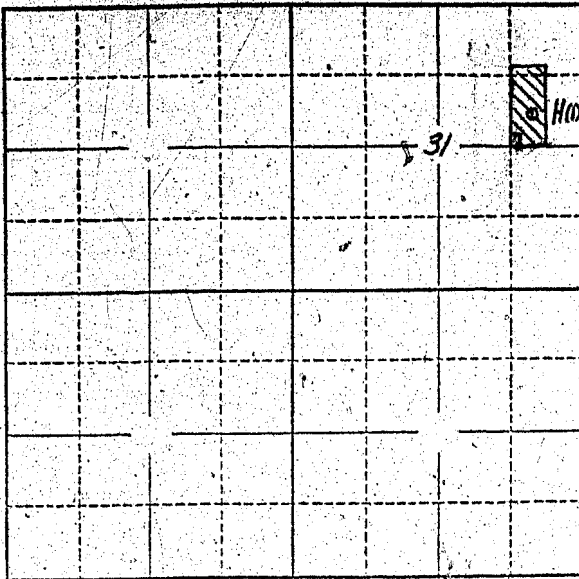

Locate well and acreage of irrigated land on plat.
Scale: 2" = 1 Mile

STATE OF OREGON

County of _____ } ss.

I, Herman Howard, being first duly sworn, do hereby certify that I have read the foregoing Registration Statement and that all of the items therein contained are true to the best of my knowledge and belief.

Herman Howard
(Signature of Registrant)

Subscribed and sworn to before me this 5th day of March, 1957.

My commission expires Sept. 2, 1960, Chas. S. Fisher
(Notary Public)

(SEAL)

CERTIFICATE OF REGISTRATION

STATE OF OREGON

County of Marion } ss.

This is to certify that the foregoing Registration Statement was received in the office of the State Engineer on the 5th day of March, 1957, at 10:00 o'clock A. M. and has been duly recorded in said office in Book No. 3 of Registration Statements on page GR-370 C.

~~Construction work is complete by _____ and the water is completely applied to beneficial use by _____~~

Witness my hand this 30th day of April, 1957.
Lewis A. Stealy
(State Engineer)

By _____
(Deputy)

GR 370 C