

Registration Statement

Registration No. GR. 3831

Certificate No. GR. 3492

OF CLAIMANT OF RIGHT TO APPROPRIATE GROUND WATER

TO THE STATE ENGINEER OF OREGON:

I, William T. Perry
of 41.1 E. 1st; Town, Oregon County of Marion
(Mailing address)

State of Oregon, do hereby make application for a certificate of registration as evidence of a right to appropriate ground water.

1. Source from which water is withdrawn is Flowing well #8
(Flowing well, pump well, infiltration trench, or tunnel)

2. Location is: 3 mi East of Marion
(Approximate distance and direction from nearest city or town)

and is more particularly described as follows:

(a) 30' South and 619' East of SE corner of NW 1/4 of NE 1/4
(Give distance and bearing to corner of section or other legal subdivision)
being within SW 1/4 of NE 1/4 of Sec. 25, Twp. 7 N, Rge. 2 W
(Smallest legal subdivision) (N. or S.) (E. or W.)

or (b) within limits of recorded platted property, town or city:

in Lot _____, Block _____ of _____
(Name of plat or addition)

County of Marion
(If within city or town, give name)

3. Construction Work was begun on Sept 1955; was completed on Sept 1955
(Date) (Date)

and the ground water claimed was first used for the purposes set out below on Sept 1955
(Date)

since which time the water has been used Continuously
(Continuously or Intermittently)

from Sept 1955 to Feb 1956
(Date) (Date)

4. Quantity of water claimed and used is 555 gallons per minute; _____ acre feet per year.

5. Purpose or Purposes for which water is used Domestic

(Domestic, irrigation, municipal, manufacturing, industrial, etc.)

6. Description of Well: Depth 22 feet. Type Drilled
(Dig or drilled)

diameter _____ inches. Elevation of ground at well site 380 feet, mean sea level.
(As near as known)

Depth to water table 1 feet.

7. Capacity of Well: 400 g.p.m. with 15 feet drawdown.

_____ g.p.m. with _____ feet drawdown.

Date of test Sept 1955

If Flowing Well: Measured discharge _____ g.p.m. on _____
(Date)

Shut-in pressure at ground surface _____ lbs. per sq. in. on _____
(Date)

Water is controlled by _____
(Cap, valve, etc.)

size.)

8 inch diameter from 0 to 22 feet

inch diameter from to feet

inch diameter from to feet

inch diameter from to feet

Describe and show depth of shoe, plug, adapter, liner or other details: _____

9. Perforated Casings or Screens:

3 per foot 3/8 x 10" from 10' to 20'

(Number per foot and size of perforations, or describe screen)

from to

from to

from to

from to


10. **Log of Well:** (Describe each stratum or formation clearly, indicate if water bearing, and give thickness and depth as indicated.)

[illegible]

Map in Gr 3824

Township 9S Range 2W, W.M.

North

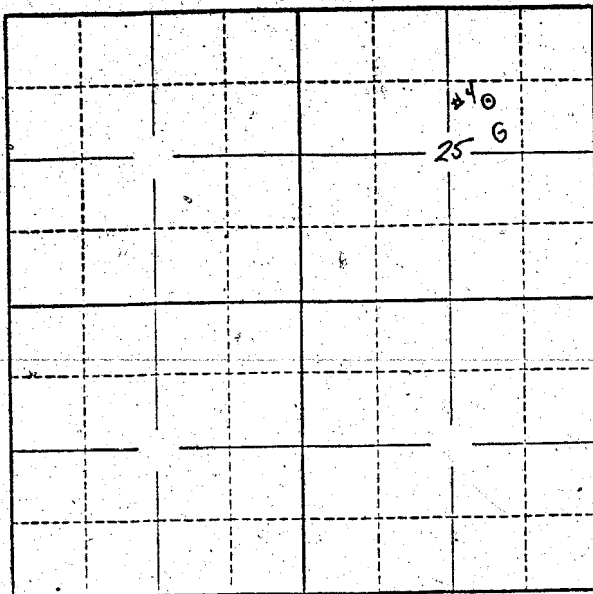

Locate well and acreage of irrigated land on plat.

Scale: 2" = 1 Mile

STATE OF OREGON

County of Marion

} ss.

I, William Towery, being first duly sworn, do hereby certify that I have read the foregoing Registration Statement and that all of the items therein contained are true to the best of my knowledge and belief.

William Towery
(Signature of Registrant)

Subscribed and sworn to before me this 31 day of July, 1958

My commission expires

MY COMMISSION EXPIRES JAN. 1, 1959

(Notary Public)

(SEAL)

CERTIFICATE OF REGISTRATION

STATE OF OREGON

County of Marion

} ss.

This is to certify that the foregoing Registration Statement was received in the office of the State Engineer on the 1st day of August, 1958, at 4:45 o'clock P. M. and has been duly recorded in said office in Book No. 14 of Registration Statements on page GR-3492

Witness my hand this 15th day of September

19 59

W. A. Stanley
(State Engineer)

By

(Deputy)

GR 3492