

Registration Statement

OF CLAIMANT OF RIGHT TO APPROPRIATE GROUND WATER

TO THE STATE ENGINEER OF OREGON:

I, EVERETT GEORGE

of P. O. Box 44, Woodburn County of Marion
(Mailing address)

State of Oregon, do hereby make application for a certificate of registration as evidence of a right to appropriate ground water.

1. Source from which water is withdrawn is pump well
(Flowing well, pump well, infiltration trench, or tunnel)

2. Location is: 3 miles west of Woodburn and 5 miles north of Geneva ;
(Approximate distance and direction from nearest city or town)

and is more particularly described as follows:

(a) Northerly along County Rd 1306' from SW Cor JB Auchibon D.C. thence
 Westerly along County Rd 250' thence Southerly parallel with West line Lot 13, 108'
(Give distance and bearing to corner of section or other legal subdivision)

being within SW 1/4 of SE 1/4 of Sec. 11 , Twp. 5 S , Rge. 2 W
(Smallest legal subdivision) (N. or S.) (E. or W.)

or (b) within limits of recorded platted property, town or city

in Lot 12 & 13 , Block of West Woodburn Fruit Farms
(Name of plat or addition)

in JB Auchibon D.C. County of Marion
(If within city or town, give name)

3. Construction Work was begun on Feb. 5, 1955 ; was completed on Feb. 10, 1955
(Date) (Date)

and the ground water claimed was first used for the purposes set out below on May 1, 1955
(Date)

since which time the water has been used intermittently each summer
(Continuously or Intermittently)

from May 1 to October 1 each year
(Date) (Date)

4. Quantity of water claimed and used is 100 gallons per minute; 50 acre feet per year.

5. Purpose or Purposes for which water is used irrigation

(Domestic, irrigation, municipal, manufacturing, industrial, etc.)

6. Description of Well: Depth 20 feet. Type drilled
(Dug or drilled)

diameter 12 inches. Elevation of ground at well site 118 feet, mean sea level.
(As near as known)

Depth to water table 20 feet.

7. Capacity of Well: 100 g.p.m. with 20 feet drawdown.

500 g.p.m. with 40 feet drawdown.

Date of test Feb. 10, 1955

If Flowing Well: Measured discharge 0 g.p.m. on
(Date)

Shut-in pressure at ground surface lbs. per sq. in. on
(Date)

Water is controlled by
(Cap, Valve, etc.)

8. **Casing:** (Give diameter, commercial specifications and depth below ground surface of each casing size.)

6 inch diameter steel casing from ground to 90 feet

inch diameter from to feet

inch diameter from to feet

inch diameter from to feet

Describe and show depth of shoe, plug, adapter, liner or other details:

9. **Perforated Casings or Screens:**

none from to
(Number per foot and size of perforations, or describe screen)

from to

from to

from to

10. **Log of Well:** (Describe each stratum or formation clearly, indicate if water bearing, and give thickness and depth as indicated.)

MATERIAL	Thickness (Feet)	Depth to Bottom (Feet)
<u>unk</u>		

If log of well is not available, give name and address of driller. Willamette Drilling Company

Address Salem, Oregon Located at Brooks, Oregon

11. Infiltration Trench: Covered or open None

Dimensions: Length _____ ft. Minimum depth _____ ft. Maximum depth _____ ft.

Bottom width _____ ft. Discharge _____ g.p.m. Date of test _____

12. Tunnel: Type of lining None

Dimensions: _____
(Length, course, and cross sectional size)

Position of water bearing stratum with reference to portal of tunnel _____

Log of tunnel: (Preceding table for log of well may be used, if desired. Give footage from portal and character of materials, as pertinent.)

13. Pumping Equipment:

(a) Pump Berkley Jet 5 horse Capacity 100 g.p.m.
(Make, type and size)

(b) Motor 5 horse
(Type and horsepower)


14. Location of area irrigated or to be irrigated, or place of use if for purposes other than irrigation.

Township North or South	Range E. or W. of Willamette Meridian	Section	Forty-acre Tract	Number Acres To Be Irrigated	Date of Reclamation
T5S	R2W	11	NW ¼ of SW ¼	.75	May 1955
"	"	11	SW ¼ of SW ¼	3.0	"
"	"	11	NE ¼ of SW ¼	.25	"
"	"	11	SE ¼ of SW ¼	2.0	"
				6.0 Total	"

15. If the ground water supply is supplemental to an existing water supply, identification of any application for a permit, permit, certificate or adjudicated right to appropriate water made or held by the registrant.

none

Township 55 Range 2 W W.M.
North

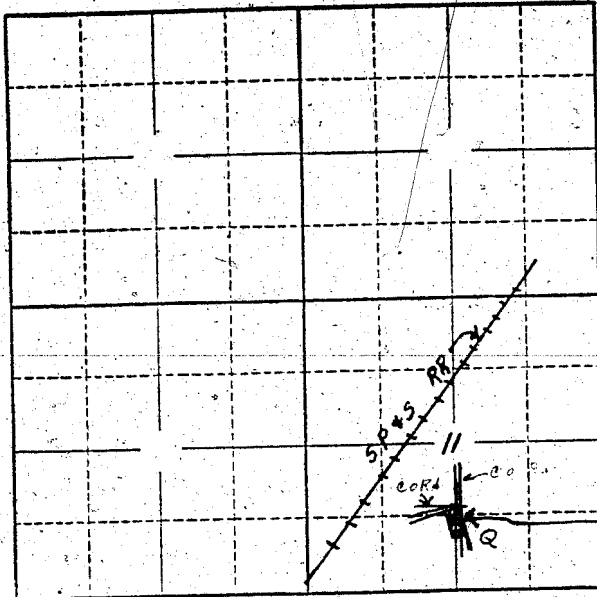

Locate well and acreage of irrigated land on plat.
Scale: 2" = 1 Mile

STATE OF OREGON

County of

} ss.

I,, being first duly sworn, do hereby certify that I have read the foregoing Registration Statement and that all of the items therein contained are true to the best of my knowledge and belief.

Everett George
(Signature of Registrant)

Subscribed and sworn to before me this 28th day of July, 1957

My commission expires 11-23-58

Raphael J. Lamb
(Notary Public)

(SEAL)

CERTIFICATE OF REGISTRATION

STATE OF OREGON

County of Marion

} ss.

This is to certify that the foregoing Registration Statement was received in the office of the State Engineer on the 1st day of August, 1958, at 4:45 o'clock P. M. and has been duly recorded in said office in Book No. 14 of Registration Statements on page GR-3493

Witness my hand this 15th day of September

1959

Edward A. Stanley
(State Engineer)

By

(Deputy)

*15.00

GR 3493