

Registration Statement

OF CLAIMANT OF RIGHT TO APPROPRIATE GROUND WATER

TO THE STATE ENGINEER OF OREGON:

I, Forrest E. Drake

of Route 4, Box 507, Grants Pass, County of Jackson

State of Oregon, do hereby make application for a certificate of registration as evidence of a right to appropriate ground water.

1. Source from which water is withdrawn is Sump (Infiltration Trench)

2. Location is: 20 miles West of Jacksonville, Oregon

and is more particularly described as follows:

(a) 710 feet south and 1200 feet West from the center of Section 6

being within NE 1/4 SW 1/4 of Sec. 6, Twp. 38 S., Rge. 4 W.

or (b) within limits of recorded platted property, town or city:

in Lot _____, Block _____ of _____

County of _____

3. Construction Work was begun on October 1953; was completed on October 1953

and the ground water claimed was first used for the purposes set out below on May 1954

since which time the water has been used continuously

from May 1954 to present

4. Quantity of water claimed and used is 400 gallons per minute; 320 acre feet per year.

5. Purpose or Purposes for which water is used irrigation

6. Description of SUMP Well: Depth 15 feet. Type Dug

diameter 40' x 100'. Elevation of ground at well site 1180 feet, mean sea level.

Depth to water table 9.0 feet.

7. Capacity of Well: _____ g.p.m. with _____ feet drawdown.


Date of test none

If Flowing Well: Measured discharge _____ g.p.m. on _____

Shut-in pressure at ground surface _____ lbs. per sq. in. on _____

Water is controlled by _____

Township 38 S. Range 4 W., W.M.
North

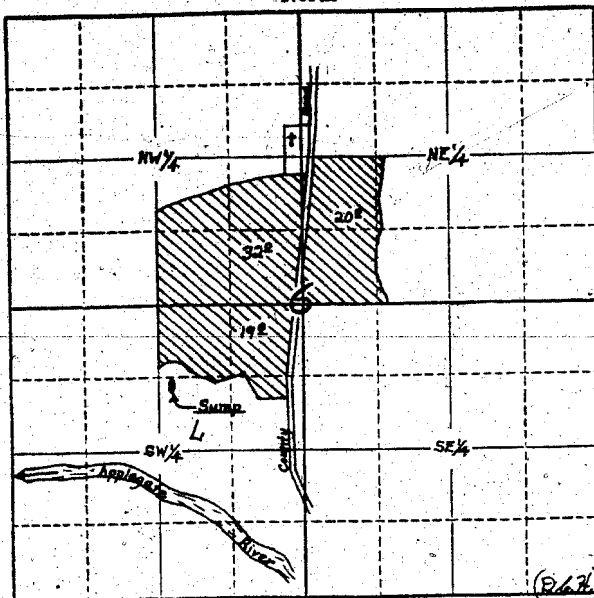

Locate well and acreage of irrigated land on plat.
Scale: 4" = 1 Mile

STATE OF OREGON }
County of Josephine } ss.
Jackson

I, Forrest E. Drake, being first duly sworn, do hereby certify that I have read the foregoing Registration Statement and that all of the items therein contained are true to the best of my knowledge and belief.

Forrest E. Drake
(Signature of Registrant)

Subscribed and sworn to before me this 30th day of July, 1958

My commission expires Sept 6 - 1961 G. C. Sherlock
(Notary Public)

(SEAL)

CERTIFICATE OF REGISTRATION

STATE OF OREGON }
County of Marion } ss.

This is to certify that the foregoing Registration Statement was received in the office of the State Engineer on the 1st day of August, 1958, at 1:00 o'clock P. M. and has been duly recorded in said office in Book No. 14 of Registration Statements on page 62-3494

Witness my hand this 15th day of September, 1959

Alvin J. Stanley
(State Engineer)

By _____ (Deputy)

\$ 21.15