

Registration Statement

OF CLAIMANT OF RIGHT TO APPROPRIATE GROUND WATER

TO THE STATE ENGINEER OF OREGON:

I, Robert M Stewart

of P.O. Box 44 Beaverton

County of Washington

State of Oregon, do hereby make application for a certificate of registration as evidence of a right to appropriate ground water.

1. Source from which water is withdrawn is pump well
(Flowing well, pump well, infiltration trench, or tunnel)

2. Location is: 1/2 mile south of City limits of Beaverton
(Approximate distance and direction from nearest city or town)

and is more particularly described as follows: about 2460 ft. North & 1950 ft. west from SE Corner, Section 21

(a) ~~470' So and 170' West of NE Cor of Lot 6 Yrex Subdivision~~
(Give distance and bearing to corner of section or other legal subdivision)

being within NW 1/4 of SE 1/4 of Sec. 21, Twp. 15, Rge. 1W
(Smallest legal subdivision) (N, S, E, or W.)

or (b) within limits of recorded platted property, town or city:

in Lot 6, Block _____ of Yrex Subdivision
(Name of plat or addition)

County of Washington

(If within city or town, give name)

3. Construction Work was begun on Oct 1951; was completed on Nov 1951
(Date) (Date)

and the ground water claimed was first used for the purposes set out below on Spring 1952
(Date)

since which time the water has been used during irrigation season
(Continuously or intermittently)

from 1952 to 1958
(Date) (Date)

4. Quantity of water claimed and used is 42 gallons per minute; _____ acre feet per year.

5. Purpose or Purposes for which water is used Irrigation

(Domestic, irrigation, municipal, manufacturing, industrial, etc.)

6. Description of Well: Depth 140 ± feet. Type Drilled
(Dug or drilled)

diameter 6 inches. Elevation of ground at well site 270 feet, mean sea level.
(As near as known)

Depth to water table 8.5 feet.

7. Capacity of Well: 42 g.p.m. with 1 1/2 feet drawdown.

_____ g.p.m. with _____ feet drawdown.


Date of test Dec 1951

If Flowing Well: Measured discharge _____ g.p.m. on _____
(Date)

Shut-in pressure at ground surface _____ lbs. per sq. in. on _____
(Date)

Water is controlled by _____
(Cap, valve, etc.)

Township 1S Range 1W, W.M.
North

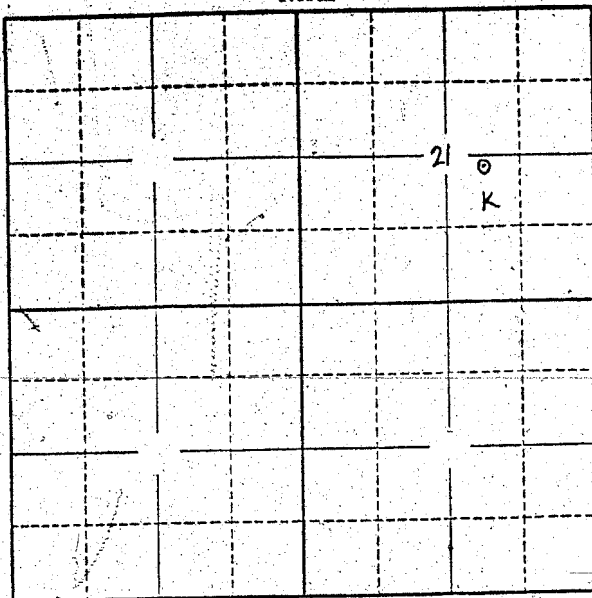

Locate well and acreage of irrigated land on plat.
Scale: 2" = 1 Mile See attached Survey Plat

STATE OF OREGON

County of WASHINGTON } ss.

I, Robert M Stewart, being first duly sworn, do hereby certify that I have read the foregoing Registration Statement and that all of the items therein contained are true to the best of my knowledge and belief.

Robert M Stewart
(Signature of Registrant)

Subscribed and sworn to before me this 31 day of July, 1958

My commission expires 2-15-59
(Notary Public)

(SEAL)

CERTIFICATE OF REGISTRATION

STATE OF OREGON } ss.
County of Marion

This is to certify that the foregoing Registration Statement was received in the office of the State Engineer on the 1 day of August, 1958, at 8:00 o'clock A. M. and has been duly recorded in said office in Book No. 14 of Registration Statements on page GR-3497

Witness my hand this 15th day of September, 1959

Lewis A. Stanley
(State Engineer)

By _____ (Deputy)

\$15.00

GR 3497