

GR-3845

GR-3502

REGISTRATION STATEMENT OF CLAIMANT OF RIGHT TO APPROPRIATE GROUND WATER AND APPLICATION FOR A CHANGE IN THE POINT OF DIVERSION

To the State Engineer of Oregon:

I, T. Leland Brown, of P. O. Box 12, The Dalles, County of Wasco, State of Oregon, do hereby make application for a certificate of registration as evidence of a right to appropriate ground water and for a change in the point of diversion of less than one-quarter mile as provided in Sections 537.705, 540.520 and 540.530 ORS.

1. Source from which water is withdrawn - pump well.
2. Location is: Approximately 7 miles west of the City of Dufur, Oregon.
3. Construction Work on old point of diversion was before June, 1921, when the applicant became acquainted with the will and the appropriation of water therefrom by one E. J. Collins, former owner of the lands hereinafter described, who appropriated and used the water for beneficial use for domestic, stock and the irrigation of approximately 5 acres of land hereinafter described. That the said E. J. Collins used said water each and every year until he sold said property to Joseph Kaufman, and Kaufman used the water continuously for said purposes until he sold the property to James L. Kelly who used the water continuously for said purposes. Subsequently said lands, well and water were acquired by Norman Hastings and conveyed to the applicant, and at all times mentioned herein such water has been used continuously for the purposes herein described.

The old point of diversion of said ground water was located as follows:

- (a) 764 feet west and 310 feet south of the quarter corner between Section 36, Township 1 South of Range 12, and Section 1, Township 2 South of Range 12, being within Lot 3 of Section 1, Township 2 South of Range 12 East of the Willamette Meridian in Wasco County, Oregon.

The new point of diversion for said well is located as follows:

(b) 759 feet west and 175 feet south of the quarter corner between Section 36, Township 1 South of Range 12, and Section 1, Township 2 South of Range 12, being within Lot 3 of Section 1, Township 2 South of Range 12 East of the Willamette Meridian in Wasco County, Oregon.

4. The old well or point of diversion was constructed and in use prior to June, 1921 by one E. J. Collins, who is now deceased. The applicant became acquainted with said appropriation on that date and the water has been beneficially used for stock, domestic and irrigation purposes continuously since 1921. The old point of diversion was partly destroyed in the flood of the winter of 1954-55 and for that reason a new point of diversion or well was drilled and completed in June, 1956. To avoid further trouble from floods and the freezing of pipes across Ramsey Creek the applicant moved the point of diversion north of Ramsey Creek so that the pipeline would not have to cross said stream and so that the point of diversion would be nearer the buildings. That the same pipeline and water system north of Ramsey Creek is used in the delivery of water from the new point of diversion, the new point of diversion being in the same quarter section and approximately 125 feet north of the former point of diversion. That since the new point of diversion has been constructed the water has been used continuously for stock, domestic and irrigation purposes.

5. Quantity of water claimed is 28 gallons per minute.

6. Purpose or Purposes for which water is used - stock, domestic and irrigation.

7. Description of Well at new point of diversion: Depth 185 feet. Type - drilled, diameter 10 inches for first 33 feet; 8 inches for next 152 feet. Elevation of ground at well site - 1500 feet, mean sea level. Depth to water table - 129 feet.

GR - 3502

8. Capacity of well: 28 g.p.m. with 30 feet drawdown.

9. Casing: 10 inch diameter from 0 feet to 33 feet.

Describe and show depth of shoe, plug, adapter, liner or other details: 10 inch welded, strata sealed against pollution at surface and 0 to 33 feet.

10. Log of Well:

Material	Thickness	Depth to Bottom
Sandy loam		0 to 6 feet
Sandy loam with blue clay		6 to 12 feet
Gravel		12 to 16 feet
Grey sandstone		16 to 33 feet
Grey sandstone		133 to 185 feet

11. Pumping Equipment:

(a) Pump - Fairbanks-Morse submersible - Capacity 28 g.p.m.

(b) Motor - Fairbanks-Morse, 2 h.p. electric


12. Location of area irrigated or to be irrigated, or place of use if for purposes other than irrigation.

Township	Range	Section	Forty-acre Tract	No. of Acres to be Irrigated	Date Reclamation
North or South	E or W of Willamette Meridian				
1 S	12 E.	36	SE 1/4 SW 1/4	.75	1921
2 S	12 E.	Lot 3		4.25	1921

13. If the ground water supply is supplemental to an existing water supply, identification of any application for a permit, permit, certificate or adjudicated right to appropriate water made or held by the applicant. - The irrigated land is supplemental to an existing right adjudicated In the Matter of the Determination of the Relative Rights to the Use of the Waters of Fifteen-Mile Creek, a tributary of the Columbia River, and a water certificate has been issued and recorded in Volume 1 of Water Rights of Wasco County, Oregon, at Page 192. That said right has a priority date of 1863 and the certificate was issued to the late J. E. Collins.

GR- 3502

Township 1 S. Range 12 E., W.M.  
Township 2 S. Range 12 E., W.M.

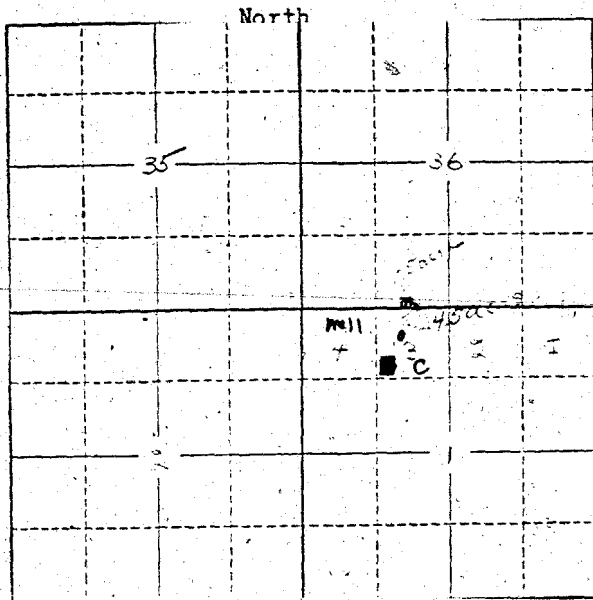

T 1 S.

T 2 S.

STATE OF OREGON )  
County of Wasco ) ss. R 12 E W M.

I, T. Leland Brown, being first duly sworn, do hereby certify that I have read the foregoing Registration Statement of Right to Appropriate Ground Water and Application for a Change in the Point of Diversion and that all of the items therein contained are true to the best of my knowledge and belief.

*T. Leland Brown*

Subscribed and sworn to before me this 31st day of July, 1958.

*[Signature]*  
Notary Public for Oregon  
My Commission expires: January 4, 1962

CERTIFICATE OF REGISTRATION

STATE OF OREGON )  
County of Marion ) ss.

This is to certify that the foregoing Registration Statement of Right to Appropriate Ground Water and Application for a Change in the Point of Diversion was received in the office of the State Engineer on the 1st day of August, 1958, at 8:00 o'clock A.M. and has been duly recorded in said office in Book No. 15 of Registration Statements on Page GR-3502.

Witness my hand this 15<sup>th</sup> day of ~~August 1958~~ September, 1959.

*[Signature]*  
State Engineer

By \_\_\_\_\_ Deputy