

Registration No. GR - 3850

Certificate No. GR - 3506

Registration Statement

OF CLAIMANT OF RIGHT TO APPROPRIATE GROUND WATER

TO THE STATE ENGINEER OF OREGON:

I, Mureen Rutherford Portland 33,
of 16517 SE Stark County of Multnomah
(Mailing address)

State of Oregon do hereby make application for a certificate of registration as evidence of a right to appropriate ground water.

1. Source from which water is withdrawn is Pump well
(Flowing well, pump well, infiltration trench, or tunnel)

2. Location is: 10 miles East Portland
(Approximate distance and direction from nearest city or town)

and is more particularly described as follows:

(a) N 80°00' E SW cor Sec 31
(Give distance and bearing to corner of section or other legal subdivision)
being within SW 1/4 SW 1/4 of Sec. 31, Twp. 1 N, Rge. 3 E
(Smallest legal subdivision) (N. or S.) (E. or W.)

or (b) within limits of recorded platted property, town or city: _____
in Lot _____, Block _____ of _____
(Name of plat or addition)

County of _____
(If within city or town, give name)

3. Construction Work was begun before 1936; was completed before 1936
(Date) (Date)

and the ground water claimed was first used for the purposes set out below before 1936
(Date)

since which time the water has been used continuously
(Continuously or intermittently)
from 1936 to 1957
(Date) (Date)

4. Quantity of water claimed and used is 30 gallons per minute; _____ acre feet per year.

5. Purpose or Purposes for which water is used irrigation
(Domestic, irrigation, municipal, manufacturing, industrial, etc.)

6. Description of Well: Depth 80 feet. Type Dug
(Dug or drilled)
diameter 36 inches. Elevation of ground at well site 300 feet, mean sea level.
(As near as known)
Depth to water table unknown feet.

7. Capacity of Well: _____ g.p.m. with _____ feet drawdown.
_____ g.p.m. with _____ feet drawdown.


Date of test No test

If Flowing Well: Measured discharge _____ g.p.m. on _____
(Date)

Shut-in pressure at ground surface _____ lbs. per sq. in. on _____
(Date)

Water is controlled by _____
(Cap, valve, etc.)

Township 1N Range 3E W.M.
North

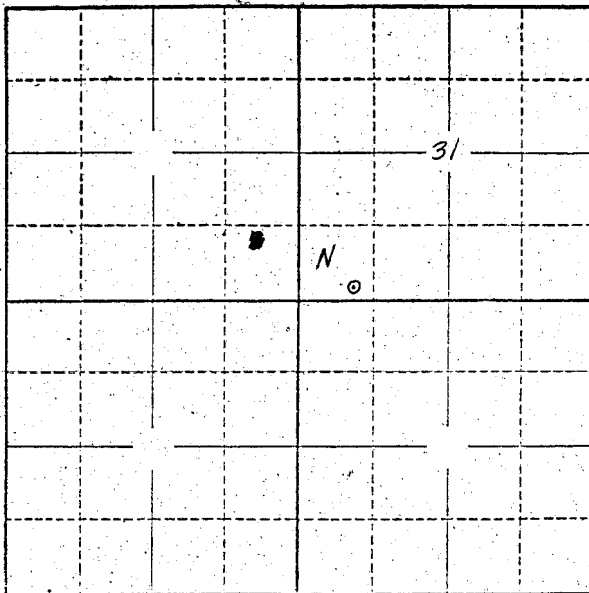

Locate well and acreage of irrigated land on plat.

Scale: 2" = 1 Mile

STATE OF OREGON

County of Wash

} ss.

I, William Guthrie, being first duly sworn, do hereby certify that I have read the foregoing Registration Statement and that all of the items therein contained are true to the best of my knowledge and belief.

William Guthrie
(Signature of Registrant)

Subscribed and sworn to before me this 31 day of July, 1958

My commission expires

1960
Jerry S. G. Longley
(Notary Public)

(SEAL)

CERTIFICATE OF REGISTRATION

STATE OF OREGON

County of Marion

} ss.

This is to certify that the foregoing Registration Statement was received in the office of the State Engineer on the 1 day of August, 1958, at 1 o'clock A.M. and has been duly recorded in said office in Book No. 15 of Registration Statements on page GR-3506

Witness my hand this 15th day of September, 1959

\$15.00

W. S. G. Longley
(State Engineer)

By _____
(Deputy)

GR 3506