

Registration Statement

OF CLAIMANT OF RIGHT TO APPROPRIATE GROUND WATER

TO THE STATE ENGINEER OF OREGON:

I, JOHN WESLEY BAILEY

of Milton Freewater R#3 Bailey County of Umatilla

State of Oregon, do hereby make application for a certificate of registration as evidence of a right to appropriate ground water.

1. Source from which water is withdrawn is Pump Well
(Flowing well, pump well, infiltration trench, or tunnel)

2. Location is: 2 1/2 miles north of Milton Freewater
(Approximate distance and direction from nearest city or town)

and is more particularly described as follows: a point 30' N from a pt 30' west from the South East Corner of SE 4 NW 4 of sec 26
(Give distance and bearing to corner of section or other legal subdivision)

being within SE 4 of NW 4 of Sec. 26, Twp. 6N, Rge. 35E
(Smallest legal subdivision) (N. or S.) (E. or W.)

or (b) within limits of recorded platted property, town or city:

in Lot _____, Block _____ of _____

County of Umatilla
(If within city or town, give name)

3. Construction Work was begun on unknown; was completed on 1903
(Date) (Date)

and the ground water claimed was first used for the purposes set out below on June 1-1903
(Date)

since which time the water has been used intermittently
(Continuously or intermittently)

from June 1903 to Sept 1955
(Date) (Date)

4. Quantity of water claimed and used is 400 gallons per minute; 270 acre feet per year.

5. Purpose or Purposes for which water is used Irrigation
(Domestic, irrigation, municipal, manufacturing, industrial, etc.)

6. Description of Well: Depth 80 feet. Type Dug 30', Drilled 50'
(Dig or drilled)
diameter 8 inches. Elevation of ground at well site 870 feet, mean sea level.
(As near as known)

Depth to water table 30 feet. in July

7. Capacity of Well: 400 g.p.m. with _____ feet drawdown. not known

_____ g.p.m. with _____ feet drawdown.

Date of test unknown

If Flowing Well: Measured discharge _____ g.p.m. on _____
(Date)

Shut-in pressure at ground surface _____ lbs. per sq. in. on _____
(Date)

Water is controlled by _____
(Cap, valve, etc.)

If log of well is not available, give name and address of driller.

None available

11. **Infiltration Trench:** Covered or open

Dimensions: Length ft. Minimum depth ft. Maximum depth ft.

Bottom width ft. Discharge g.p.m. Date of test

12. **Tunnel:** Type of lining

Dimensions:
(Length, course, and cross sectional size)

Position of water bearing stratum with reference to portal of tunnel

Log of tunnel: (Preceding table for log of well may be used, if desired. Give footage from portal and character of materials, as pertinent.)

13. **Pumping Equipment:**

(a) Pump *2 1/2 Centrifugal* Capacity *400* g.p.m.
(Make, type and size)

(b) Motor *5 H.P. 3 phase*
(Type and horsepower)


14. Location of area irrigated or to be irrigated, or place of use if for purposes other than irrigation.

Township North or South	Range E. or W. of Willamette Meridian	Section	Forty-acre Tract	Number Acres To Be Irrigated	Date of Reclamation
<i>6N</i>	<i>35E</i>	<i>26</i>	<i>SE 1/4 NW 4</i>	<i>20</i>	<i>1903</i>

15. If the ground water supply is supplemental to an existing water supply, identification of any application for a permit, permit, certificate or adjudicated right to appropriate water made or held by the registrant.

10 ac. 1887 - 10 ac. Oct. 1 - 1908, Walla Walla River
Adjudication proceedings - 1932

Township 6N Range 35E, W.M.
Sec. 26 North

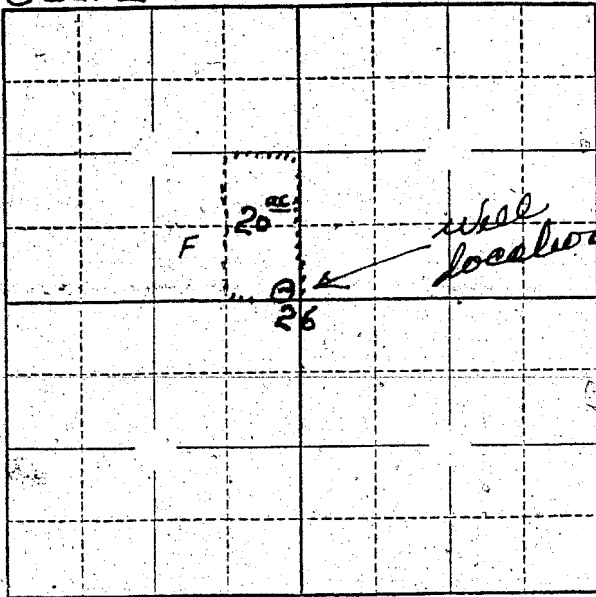

Locate well and acreage of irrigated land on plat.

Scale $\frac{1}{32} = 1$ Mile

$1'' = 1M.$

STATE OF OREGON

County of Umatilla } ss.

I, John Wesley Bailey, being first duly sworn, do hereby certify that I have read the foregoing Registration Statement and that all of the items therein contained are true to the best of my knowledge and belief.

John Wesley Bailey
 (Signature of Registrant)

Subscribed and sworn to before me this 30th day of July, 1959

My commission expires Jan. 26, 1962

G. W. Bishop
 (Notary Public)

(SEAL)

CERTIFICATE OF REGISTRATION

STATE OF OREGON

County of Marion } ss.

This is to certify that the foregoing Registration Statement was received in the office of the State Engineer on the 1st day of August, 1959, at 1:00 o'clock P.M. and has been duly recorded in said office in Book No. 15 of Registration Statements on page OR-3509

Witness my hand this 15th day of September, 1959

Henry A. Stanley
 (State Engineer)

By _____ (Deputy)

\$15.00

GR 3509