

Registration Statement

OF CLAIMANT OF RIGHT TO APPROPRIATE GROUND WATER

TO THE STATE ENGINEER OF OREGON:

I, Archie Harris

of Milton (Mailing address)

County of Clatsop

State of Ore do hereby make application for a certificate of registration as evidence of a right to appropriate ground water.

1. Source from which water is withdrawn is P. m. P. Well (Flowing well, pump well, infiltration trench, or tunnel)

2. Location is: 3 M NW of Milton (Approximate distance and direction from nearest city or town)

and is more particularly described as follows:

(a) 1385 ft S + 1550 ft W from NE corner of Sec 33 (Give distance and bearing to corner of section or other legal subdivision)

being within NE 1/4 of NE 1/4 (Smallest legal subdivision) of Sec. 33, Twp. 6 N, Rge. 35 E (N. or W.) (E. or W.)

or (b) within limits of recorded platted property, town or city:

in Lot _____, Block _____ of _____ (Name of plat or addition)

County of _____ (If within city or town, give name)

3. Construction Work was begun on 1920 (Date); was completed on 1920 (Date)

and the ground water claimed was first used for the purposes set out below on April 1920 (Date)

since which time the water has been used Continuously (Continuously or Intermittently)

from Apr (Date) to Oct (Date)

4. Quantity of water claimed and used is 190 gallons per minute; _____ acre feet per year.

5. Purpose or Purposes for which water is used Irrigation (Domestic, irrigation, municipal, manufacturing, industrial, etc.)

6. Description of Well: Depth 102 feet. Type 0.8 5 1/2 ft + Drilled 50 ft (Dug or drilled)

diameter 8 inches. Elevation of ground at well site 9.10 feet, mean sea level. (As near as known)

Depth to water table 20 to 40 feet.

7. Capacity of Well: _____ g.p.m. with _____ feet drawdown.

_____ g.p.m. with _____ feet drawdown.

Date of test _____

If Flowing Well: Measured discharge _____ g.p.m. on _____ (Date)

Shut-in pressure at ground surface _____ lbs. per sq. in. on _____ (Date)

Water is controlled by _____ (Cap, valve, etc.)

8. Casing: (Give diameter, commercial specifications and depth below ground surface of each casing size.)

8 inch diameter from 52 to 102 feet
 inch diameter from to feet
 inch diameter from to feet
 inch diameter from to feet

Describe and show depth of shoe, plug, adapter, liner or other details:

9. Perforated Casings or Screens:

..... from to
 (Number per foot and size of perforations, or describe screen)
 from to
 from to
 from to

10. Log of Well: (Describe each stratum or formation clearly, indicate if water bearing, and give thickness and depth as indicated.)

MATERIAL	Thickness (Feet)	Depth to Bottom (Feet)

If log of well is not available, give name and address of driller.....

11. Infiltration Trench: Covered or open.....

Dimensions: Length..... ft. Minimum depth..... ft. Maximum depth..... ft.

Bottom width..... ft. Discharge..... g.p.m. Date of test.....

12. Tunnel: Type of lining.....

Dimensions:.....
(Length, course, and cross sectional size)

Position of water bearing stratum with reference to portal of tunnel.....

Log of tunnel: (Preceding table for log of well may be used, if desired. Give footage from portal and character of materials, as pertinent.)

13. Pumping Equipment:

(a) Pump: Johnson 7 1/2 HP Turbine Capacity 190 g.p.m.
(Make, type and size)

(b) Motor: U.S. 7 1/2 HP
(Type and horsepower)

14. Location of area irrigated or to be irrigated, or place of use if for purposes other than irrigation.


Township North or South	Range E or W. of Willamette Meridian	Section	Forty-acre Tract	Number Acres To Be Irrigated	Date of Reclamation
6N	35E	33	NE 1/4 of NE 1/4	20	1920

15. If the ground water supply is supplemental to an existing water supply, identification of any application for a permit, permit, certificate or adjudicated right to appropriate water made or held by the registrant.

.....

Township 6 N Range 35 E, W.M.
North

SE 1/4 NE 1/4 NW 1/4
S. 33-6N-R33E

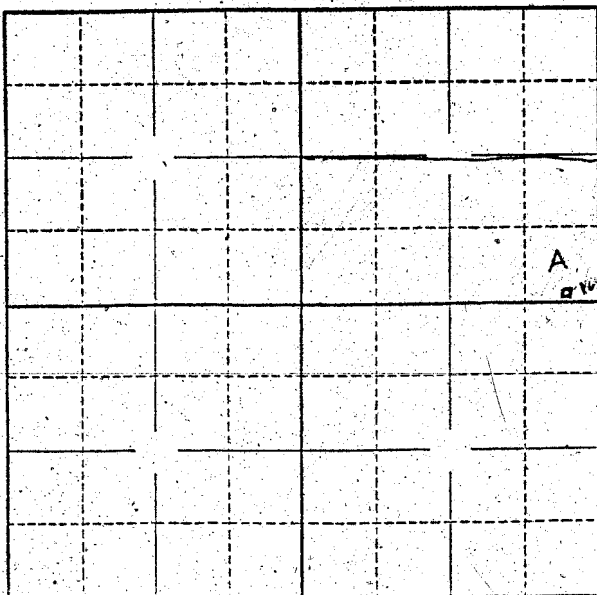

Locate well and acreage of irrigated land on plat.
Scale: 8 = 1 Mile

STATE OF OREGON

County of Clatsop } ss.

I, Archie Harris, being first duly sworn, do hereby certify that I have read the foregoing Registration Statement and that all of the items therein contained are true to the best of my knowledge and belief.

[Signature]
(Signature of Registrant)

Subscribed and sworn to before me this 14 day of August, 1958

My commission expires [Signature]
(Notary Public)

(SEAL)

CERTIFICATE OF REGISTRATION

STATE OF OREGON

County of Marion } ss.

This is to certify that the foregoing Registration Statement was received in the office of the State Engineer on the 1 day of August, 1958, at 8:00 o'clock A.M. and has been duly recorded in said office in Book No. 15 of Registration Statements on page GR-3632.

Witness my hand this 15th day of September, 1959

[Signature]
(State Engineer)

By [Signature]
(Deputy)

\$15.00

GR. 3632