

Registration Statement

OF CLAIMANT OF RIGHT TO APPROPRIATE GROUND WATER

(Under Chapter 708, Oregon Laws 1955.)

TO THE STATE ENGINEER OF OREGON:

I, Geo. S. May

of Mt. Angel Post Office County of Marion

State of Oregon, do hereby make application for a certificate of registration as evidence of a right to appropriate ground water.

1. Source from which water is withdrawn is Pump Well

(Flowing well, pump well, infiltration trench, or tunnel)

2. Location is: Approx. 6 Mi. WSW Mt. Angel (1 Mi. W. No. Howell Sch.)

(Approximate distance and direction from nearest city or town)

and is more particularly described as follows:

(a) 20 Ch. N. + 80 Ch. E From SW corner Section 13

(Give distance and bearing to corner of section or other legal subdivision)

being within NW/4 of SW/4 of Sec. 13, Twp. 6S, Rge. 2W

(Smallest legal subdivision)

(N. or S.)

(E. or W.)

or (b) within limits of recorded platted property, town or city: _____

in Lot _____, Block _____ of _____

(Name of plat or addition)

(If within city or town, give name) _____ County of _____

3. Construction Work was begun on Aug. 1953; was completed on August 1953

(Date)

(Date)

and the ground water claimed was first used for the purposes set out below on August 1953

(Date)

since which time the water has been used Continuously for irrigation

(Continuously or intermittently)

from Aug. 1953 to Mar. 1957

(Date)

(Date)

4. Quantity of water claimed and used is 210 gallons per minute; _____ acre feet per year.

5. Purpose or Purposes for which water is used IRRIGATION

(Domestic, irrigation, municipal, manufacturing, industrial, etc.)

6. Description of Well: Depth 140 feet. Type DRILLED

(Dug or drilled)

diameter 8 inches. Elevation of ground at well site 152 feet, mean sea level.

(As near as known)

Depth to water table 30 feet.

7. Capacity of Well: 700 g.p.m. with 40 feet drawdown.

_____ g.p.m. with _____ feet drawdown.

Date of test 9/4/53

If Flowing Well: Measured discharge _____ g.p.m. on _____

(Date)


Shut-in pressure at ground surface _____ lbs. per sq. in. on _____

(Date)

Water is controlled by _____

(Cap, valve, etc.)

Township 6S Range 2W, W.M.
North

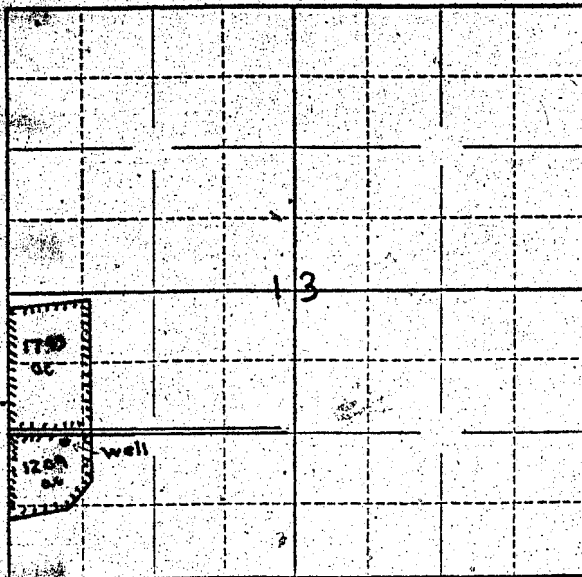

Locate well and acreage of irrigated land on plat.

Scale: $\frac{1}{4}$ " = 1 Mile

STATE OF OREGON

County of Marion } ss.

I, Geo S May, being first duly sworn, do hereby certify that I have read the foregoing Registration Statement and that all of the items therein contained are true to the best of my knowledge and belief.

Geo S May
(Signature of Registrant)

Subscribed and sworn to before me this 7th day of March, 1957

My commission expires Sept 8, 1960 Chas T White
(Notary Public)

(SEAL)

CERTIFICATE OF REGISTRATION

STATE OF OREGON

County of Marion } ss.

This is to certify that the foregoing Registration Statement was received in the office of the State Engineer on the 7th day of March, 1957, at 2:00 o'clock P.M. and has been duly recorded in said office in Book No. 3 of Registration Statements on page GR-374 C.

~~Construction shall be completed by x-x-x-x-x-x-x-x-x-x and the water completely applied to x
beneficial use by x-x-x-x-x-x-x-x-x-x~~

Witness my hand this 30th day of April, 1957

Stuart G. Stanley
(State Engineer)

By _____
(Deputy)

\$15.00