

Registration Statement

OF CLAIMANT OF RIGHT TO APPROPRIATE GROUND WATER

TO THE STATE ENGINEER OF OREGON:

I, Virgil Bish

of Rt. 2, Box 212, Beaverton County of Washington

(Mailing address)

State of Oregon, do hereby make application for a certificate of registration as evidence of a right to appropriate ground water.

1. Source from which water is withdrawn is pump well
(Flowing well, pump well, infiltration trench, or tunnel)

2. Location is: one mi. N. of Scholls
(Approximate distance and direction from nearest city or town)

and is more particularly described as follows:

(a) 1830 ft. N. & 60 ft. E. of S. A cor. Sec. 3
(Give distance and bearing to corner of section or other legal subdivision)

being within NW 1/4 SE 1/4 of Sec. 3, Twp. 2S, Rge. 2W
(Smallest legal subdivision) (N. or S.) (E. or W.)

or (b) within limits of recorded platted property, town or city:

in Lot _____, Block _____ of _____
(Name of plat or addition)

County of _____
(If within city or town, give name)

3. Construction Work was begun on 1922; was completed on 1922
(Date) (Date)

and the ground water claimed was first used for the purposes set out below on 1922
(Date)

since which time the water has been used continuously
(Continuously or Intermittently)

from 1922 to present
(Date) (Date)

4. Quantity of water claimed and used is 33 gallons per minute; _____ acre feet per year.

5. Purpose or Purposes for which water is used Irrig. & put byer

(Domestic, irrigation, municipal, manufacturing, industrial, etc.)

6. Description of Well: Depth 70 feet. Type Drilled
(Dug or drilled)

diameter 10 inches. Elevation of ground at well site 100 feet, mean sea level.
(As near as known)

Depth to water table 11.3 feet.

7. Capacity of Well: _____ g.p.m. with _____ feet drawdown.

_____ g.p.m. with _____ feet drawdown.


Date of test no test

If Flowing Well: Measured discharge _____ g.p.m. on _____
(Date)

Shut-in pressure at ground surface _____ lbs. per sq. in. on _____
(Date)

Water is controlled by _____
(Cap. valve, etc.)

Township 25 Range 2W, W.M.
North

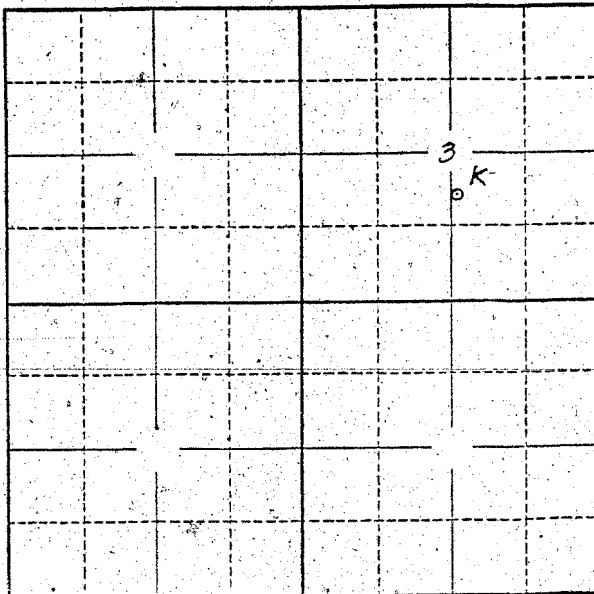

Locate well and acreage of irrigated land on plat.
Scale: 2" = 1 Mile

STATE OF OREGON

County of Marion } ss.

I, Virgil Bisk, being first duly sworn, do hereby certify that I have read the foregoing Registration Statement and that all of the items therein contained are true to the best of my knowledge and belief.

Virgil Bisk

(Signature of Registrant)

Subscribed and sworn to before me this 4th day of August, 1958

My commission expires 12th June 1961

Wm. J. Bartholomew

(Notary Public)

(SEAL)

CERTIFICATE OF REGISTRATION

STATE OF OREGON

County of Marion } ss.

This is to certify that the foregoing Registration Statement was received in the office of the State Engineer on the 4th day of August, 1958, at 8:00 o'clock A. M. and has been duly recorded in said office in Book No. 15 of Registration Statements on page GR-3522

Witness my hand this 15th day of September, 1959

Lewis A. Stanley

(State Engineer)

By _____ (Deputy)

\$ 15.00

GR 3522