

RECEIVED
AUG 1 1958
STATE ENGINEER

Registration No. GR-3874

Certificate No. GR-3524

Registration Statement

OF CLAIMANT OF RIGHT TO APPROPRIATE GROUND WATER

TO THE STATE ENGINEER OF OREGON:

I, Donald H. Giles

of Rt. # 4, Box 372, Medford, County of Jackson

State of Oregon do hereby make application for a certificate of registration as evidence of a right to appropriate ground water.

1. Source from which water is withdrawn is Pump Well
(Flowing well, pump well, infiltration trench, or tunnel)

2. Location is: 5 miles South by Southwest of Medford, Oregon
(Approximate distance and direction from nearest city or town)

and is more particularly described as follows:

(a) 1070' N and 1028' E from the SW corner of DIC #47
(Give distance and bearing to corner of section or other legal subdivision)

being within NE 1/4 SE 1/4 NW 1/4 of Sec. 11, Twp. S8 S, Rge. 2 W
(Smallest legal subdivision) (N. or S.) (E. or W.)

or (b) within limits of recorded platted property, town or city:

in Lot _____, Block _____ of _____
(Name of plat or addition)

County of _____
(If within city or town, give name)

3. Construction Work was begun on about 1900; was completed on about 1900
(Date) (Date)

and the ground water claimed was first used for the purposes set out below on about 1900
(Date)

since which time the water has been used continuously
(Continuously or intermittently)

from about 1900 to present
(Date) (Date)

4. Quantity of water claimed and used is about 16.6 gallons per minute; 9.0 acre feet per year.

5. Purpose or Purposes for which water is used irrigation of lawns and garden

(Domestic, irrigation, municipal, manufacturing, industrial, etc.)

6. Description of Well: Depth 32 feet. Type dug
(Dug or drilled)

diameter 12' ~~12"~~ Elevation of ground at well site 1640 feet, mean sea level.
(As near as known)

Depth to water table about 15 feet.

7. Capacity of Well: 16.6 g.p.m. with 12 feet drawdown.

_____ g.p.m. with _____ feet drawdown.

Date of test July 27, 1958

If Flowing Well: Measured discharge _____ g.p.m. on _____
(Date)

Shut-in pressure at ground surface _____ lbs. per sq. in. on _____
(Date)

Water is controlled by _____
(Cap, valve, etc.)

8. Casing: (Give diameter, commercial specifications and depth below ground surface of each casing size.)

144 inch diameter wall cased with rock from 0 to 32 feet
inch diameter from to feet
inch diameter from to feet
inch diameter from to feet

Describe and show depth of shoe, plug, adapter, liner or other details:

9. Perforated Casings or Screens:

None from to
(Number per foot and size of perforations, or describe screen)
from to
from to
from to

10. Log of Well: (Describe each stratum or formation clearly, indicate if water bearing, and give thickness and depth as indicated.)

MATERIAL	Thickness (Feet)	Depth to Bottom (Feet)
no knowledge of stratum or formation		

If log of well is not available, give name and address of driller. not known

11. Infiltration Trench: Covered or open none

Dimensions: Length _____ ft. Minimum depth _____ ft. Maximum depth _____ ft.

Bottom width _____ ft. Discharge _____ g.p.m. Date of test _____

12. Tunnel: Type of lining None

Dimensions: _____
(Length, course, and cross sectional size)

Position of water bearing stratum with reference to portal of tunnel _____

Log of tunnel: (Preceding table for log of well may be used, if desired. Give footage from portal and character of materials, as pertinent.)

13. Pumping Equipment:

(a) Pump 1 1/2" centrifugal Jet Pump (Berkeley) Capacity 18.6 g.p.m.
(Make, type and size)

(b) Motor 1 HP electric motor
(Type and horsepower)


14. Location of area irrigated or to be irrigated, or place of use if for purposes other than irrigation.

Township North or South	Range E. or W. of Willamette Meridian	Section	Forty-acre Tract	Number Acres To Be Irrigated	Date of Reclamation
38 S	2 W	11	SE 1/4 NW 1/4	1.9 acres	1900

15. If the ground water supply is supplemental to an existing water supply, identification of any application for a permit, permit, certificate or adjudicated right to appropriate water made or held by the registrant.

None

Township 38 S Range 2 W, W.M.
North

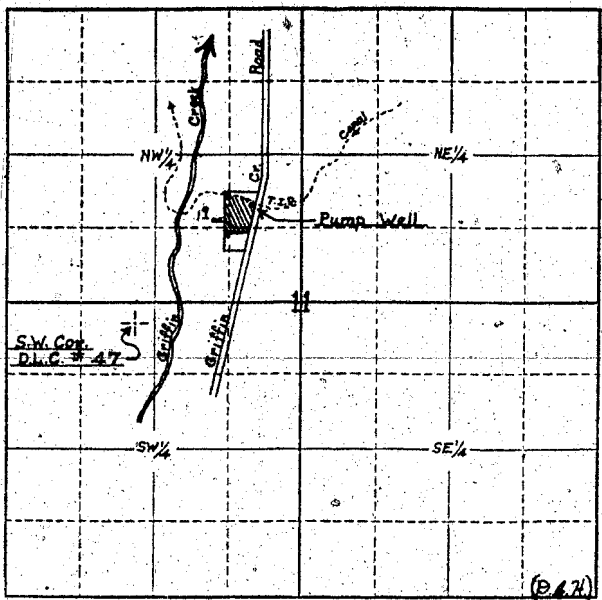

Locate well and acreage of irrigated land on plat.
Scale: **4"** = 1 Mile

STATE OF OREGON }
County of Jackson } ss.

I, Donald H. Giles, being first duly sworn, do hereby certify that I have read the foregoing Registration Statement and that all of the items therein contained are true to the best of my knowledge and belief.

X
.....
(Signature of Registrant)

Subscribed and sworn to before me this _____ day of _____, 19_____

My commission expires _____
(Notary Public)

(SEAL)

CERTIFICATE OF REGISTRATION

STATE OF OREGON }
County of Marion } ss.

This is to certify that the foregoing Registration Statement was received in the office of the State Engineer on the 1st day of August, 1958, at 8⁰⁰ o'clock A.M. and has been duly recorded in said office in Book No. 15 of Registration Statements on page GR-3524

Witness my hand this 15th day of September, 1959

Henry A. Stanley
(State Engineer)

By _____
(Deputy)

\$15.00