

20.25

Registration No. GR 3877

Certificate No. GR 3527

Registration Statement

OF CLAIMANT OF RIGHT TO APPROPRIATE GROUND WATER

TO THE STATE ENGINEER OF OREGON:

I, James E. Whelan Jr.

of Rt. 2 Box 147 Salem County of Marion

State of Oregon, do hereby make application for a certificate of registration as evidence of a right to appropriate ground water.

1. Source from which water is withdrawn is pump well
(Flowing well, pump well, infiltration trench, or tunnel)

2. Location is: 8 miles North of Salem, Ore.
(Approximate distance and direction from nearest city or town)

and is more particularly described as follows:

(a) 630' S. and 750' W. of the NE Corner of NE 1/4 of NW 1/4
(Give distance and bearing to corner of section or other legal subdivision)

being within NE 1/4 of NW 1/4 of Sec. 23, Twp. 6 S, Rge. 3 W
(Smallest legal subdivision) (N. or S.) (E. or W.)

or (b) within limits of recorded platted property, town or city:

in Lot _____, Block _____ of _____
(Name of plat or addition)

County of _____
(If within city or town, give name)

3. Construction Work was begun on May, 1944; was completed on May, 1944
(Date) (Date)

and the ground water claimed was first used for the purposes set out below on May, 1944
(Date)

since which time the water has been used intermittently
(Continuously or intermittently)

from _____ to July 1958
(Date) (Date)

4. Quantity of water claimed and used is 480 gallons per minute; 2.15 acre feet per year.

5. Purpose or Purposes for which water is used Irrigation

(Domestic, irrigation, municipal, manufacturing, industrial, etc.)

6. Description of Well: Depth 32 feet. Type Drilled
(Dug or drilled)

diameter 11 inches. Elevation of ground at well site _____ feet, mean sea level.
(As near as known)

Depth to water table _____ feet.

7. Capacity of Well: Unknown g.p.m. with Unknown feet drawdown.

_____ g.p.m. with _____ feet drawdown.


Date of test None

If Flowing Well: Measured discharge _____ g.p.m. on _____
(Date)

Shut-in pressure at ground surface _____ lbs. per sq. in. on _____
(Date)

Water is controlled by _____
(Cap, valve, etc.)

Township 6.5 Range 30, W.M.
North

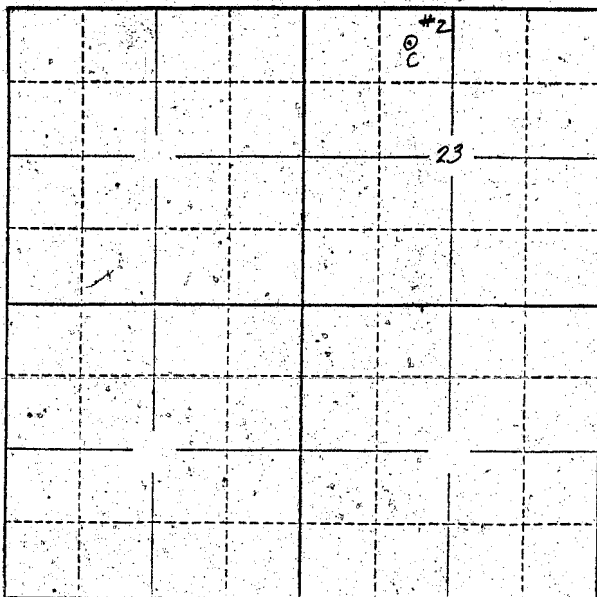

Locate well and acreage of irrigated land on plat.
Scale: 2" = 1 Mile

STATE OF OREGON

County of Marion } ss.

I, James E. Whelan Jr., being first duly sworn, do hereby certify that I have read the foregoing Registration Statement and that all of the items therein contained are true to the best of my knowledge and belief.

James E. Whelan Jr.
(Signature of Registrant)

Subscribed and sworn to before me this 4th day of August, 1958

My commission expires 12th June 1961 Wm. S. Bartholomew
(Notary Public)

(SEAL)

CERTIFICATE OF REGISTRATION

STATE OF OREGON

County of Marion } ss.

This is to certify that the foregoing Registration Statement was received in the office of the State Engineer on the 4 day of August, 1958, at 8:50 o'clock A. M. and has been duly recorded in said office in Book No. 15 of Registration Statements on page GR-3527

Witness my hand this 15th day of September, 1959

Lewis A. Standen
(State Engineer)

By _____
(Deputy)

GR 3527

20-25