

Registration Statement

OF CLAIMANT OF RIGHT TO APPROPRIATE GROUND WATER

(Under Chapter 708, Oregon Laws 1955.)

TO THE STATE ENGINEER OF OREGON:

I, Mervin Seeger 180 Boone Rd. SE
of Salem County of Marion
State of Oregon, do hereby make application for a certificate of registration as evidence of a right to appropriate ground water.

1. Source from which water is withdrawn is pump well
(Flowing well, pump well, infiltration trench, or tunnel)

2. Location is: 4 miles south of Salem
(Approximate distance and direction from nearest city or town)

and is more particularly described as follows: about 610 feet north & 1720 feet west from SE Corner Sec. 9

(a) 3/4 mile west of corners 9 & 10
(Give distance and bearing to corner of section or other legal subdivision)

being within Lot 37 Sunnyside East of Sec. 09, Twp. SS, Rge. 3W
(Smallest legal subdivision) (N. or S.) (E. or W.)

or (b) within limits of recorded platted property, town or city:

in Lot _____, Block _____ of _____
(Name of plat or addition)
County of _____
(If within city or town, give name)

3. Construction Work was begun on August 1957; was completed on 1958
(Date) (Date)

and the ground water claimed was first used for the purposes set out below on 1957
(Date)

since which time the water has been used Continuously
(Continuously or intermittently)

from 1957 to 1958
(Date) (Date)

4. Quantity of water claimed and used is 12-15 gallons per minute; _____ acre feet per year.

5. Purpose or Purposes for which water is used Irrigation
(Domestic, irrigation, municipal, manufacturing, industrial, etc.)

6. Description of Well: Depth 46 feet, Type drilled
(Dug or drilled)

diameter 6 inches. Elevation of ground at well site 156 feet, mean sea level.
(As near as known)

Depth to water table 16 feet.

7. Capacity of Well: 12-15 g.p.m. with _____ feet drawdown.

_____ g.p.m. with _____ feet drawdown.

Date of test _____

If Flowing Well: Measured discharge _____ g.p.m. on _____
(Date)

Shut-in pressure at ground surface _____ lbs. per sq. in. on _____
(Date)

Water is controlled by _____
(Cap, valve, etc.)

8. Casing: (Give diameter, commercial specifications and depth below ground surface of each casing size.)

inch diameter from to feet
inch diameter from to feet
inch diameter from to feet
inch diameter from to feet

Describe and show depth of shoe, plug, adapter, liner or other details:

9. Perforated Casings or Screens:

(Number per foot and size of perforations, or describe screen) from to
..... from to
..... from to
..... from to

10. Log of Well: (Describe each stratum or formation clearly, indicate if water bearing, and give thickness and depth as indicated.)

MATERIAL	Thickness (Feet)	Depth to Bottom (Feet)

If log of well is not available, give name and address of driller. *San Pitt*
4045 Bluff St. S.E. Salem, Ore.

11. **Infiltration Trench:** Covered or open
 Dimensions: Length ft. Minimum depth *1.5* ft. Maximum depth ft.
 Bottom width ft. Discharge g.p.m. Date of test

12. **Tunnel:** Type of lining
 Dimensions:
(Length, course, and cross sectional size)
 Position of water bearing stratum with reference to portal of tunnel

Log of tunnel: (Preceding table for log of well may be used, if desired. Give footage from portal and character of materials, as pertinent.)

13. **Pumping Equipment:**
 (a) Pump *1-horse Universal Jet* Capacity *15* g.p.m.
(Make, type and size)
 (b) Motor *1-horse Universal*
(Type and horsepower)


14. Location of area irrigated or to be irrigated, or place of use if for purposes other than irrigation.

Township North or South	Range E. or W. of Willamette Meridian	Section	Forty-acre Tract	Number Acres To Be Irrigated	Date of Reclamation
<i>T8S</i>	<i>R3W</i>	<i>C9</i>	<i>SW 1/4 of SE 1/4</i>	<i>3.0</i>	<i>1950</i>

15. If the ground water supply is supplemental to an existing water supply, identification of any application for a permit, permit, certificate or adjudicated right to appropriate water made or held by the registrant.

Township 85 Range 34, W.M.

North

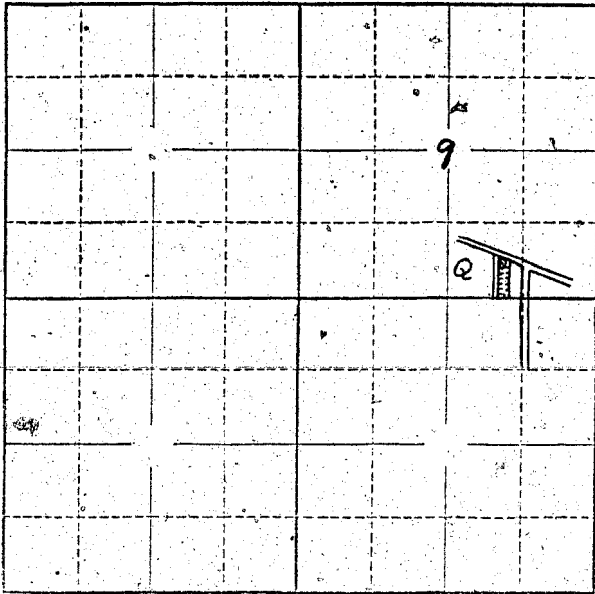

Locate well and acreage of irrigated land on plat.

Scale: 2" = 1 Mile

STATE OF OREGON

County of Marion } ss.

I, Marion Steeber, being first duly sworn, do hereby certify that I have read the foregoing Registration Statement and that all of the items therein contained are true to the best of my knowledge and belief.

(Signature of Registrant)

Subscribed and sworn to before me this 31st day of July, 1958

My commission expires Feb 18, 1959 Michael E. Lane

(Notary Public)

(SEAL)

CERTIFICATE OF REGISTRATION

STATE OF OREGON } ss.
County of Marion

This is to certify that the foregoing Registration Statement was received in the office of the State Engineer on the 4th day of August, 1958, at 2:00 o'clock A. M. and has been duly recorded in said office in Book No. 15 of Registration Statements on page GR-3528

~~Construction shall be completed by [unclear] and the water completely applied to beneficial use by [unclear].~~

Witness my hand this 15th day of September, 1959

Henry A. Stanley
(State Engineer)

By _____ (Deputy)

\$15.00

GR-3528