REGISTRATION No. GR-388

CERTIFICATE No. GR 375

Registration Statement

OF CLAIMANT OF RIGHT TO APPROPRIATE GROUND WATER

(Under Chapter 708, Oregon Laws 1955.)

TO THE STATE ENGINEER OF OREGON:

I, Phillip A. Hawman Rt 3, Box 250,

of Dundee, Oregon County of Yamhill

State of Oregon, do hereby make application for a certificate of registration as evidence of a right to appropriate ground water.

1. **Source** from which water is withdrawn is flowing well (Flowing well, pump well, infiltration trench, or tunnel)

2. **Location** is: 2 mi. south of Dundee, Oregon Yamhill County; (Approximate distance and direction from nearest city or town)

and is more particularly described as follows:

(a) 660 ft. North & 2200 ft. East of the Southwest corner Sec. 2 (Give distance and bearing to corner of section or other legal subdivision)

being within the Southwest part (Smallest legal subdivision) of Sec. 2, Twp. 4 S (N. or S.), Rge. 3 W (E. or W.)

or (b) within limits of recorded platted property, town or city:

in Lot ....., Block ..... of ..... (Name of plat or addition)

..... (If within city or town, give name) County of .....

3. **Construction Work** was begun on Aug. 1946 (Date); was completed on Aug. 1946 (Date)

and the ground water claimed was first used for the purposes set out below on Sept. 1946 (Date);

since which time the water has been used intermittently (Continuously or intermittently)

from Sept. 1946 (Date) to present date (Date)

4. **Quantity** of water claimed and used is 50 gallons per minute; ..... acre feet per year.

5. **Purpose or Purposes** for which water is used irrigation; water flows into storage pond used for irrigation, Reg. No. (Domestic, irrigation, municipal, manufacturing, industrial, etc.)

6. **Description of Well:** Depth 32 feet. Type drilled (Dug or drilled)

diameter 12 inches. Elevation of ground at well site 130 (As near as known) feet, mean sea level.

Depth to water table flowing well feet.

7. **Capacity of Well:** 50 g.p.m. with 30 feet drawdown.

..... g.p.m. with ..... feet drawdown.

Date of test Sept. 1946

If Flowing Well: Measured discharge 40 g.p.m. on Sept. 1946 (Date)

Shut-in pressure at ground surface 30 lbs. per sq. in. on Sept. 1946 (Date)

Water is controlled by Not controlled; runs into irrigation storage pond (Cap, valve, etc.)

8. **Casing:** (Give diameter, commercial specifications and depth below ground surface of each casing size.)

12 inch diameter cement tile from ground to 32 feet

inch diameter from to feet

inch diameter from to feet

inch diameter from to feet

Describe and show depth of shoe, plug, adapter, liner or other details: cement tile is packed with four inches of gravel around outer side from ground to 32 ft.

9. **Perforated Casings or Screens:**

none (Number per foot and size of perforations, or describe screen) from to

from to

from to

from to

10. **Log of Well:** (Describe each stratum or formation clearly, indicate if water bearing, and give thickness and depth as indicated.)

MATERIAL	Thickness (Feet)	Depth to Bottom (Feet)
Blue clay (non-water bearing)	25	7
Course black sand (water bearing)	5	2
Heavy blue-black clay (non-water bearing)	2	0

If log of well is not available, give name and address of driller. .....

.....

11. **Infiltration Trench:** Covered or open none

Dimensions: Length ..... ft. Minimum depth ..... ft. Maximum depth ..... ft.

Bottom width ..... ft. Discharge ..... g.p.m. Date of test .....

12. **Tunnel:** Type of lining none

Dimensions: .....
(Length, course, and cross sectional size)

Position of water bearing stratum with reference to portal of tunnel .....

.....

Log of tunnel: (Preceding table for log of well may be used, if desired. Give footage from portal and character of materials, as pertinent.)

13. **Pumping Equipment:**

(a) Pump None; (Flowing well). Capacity 40 g.p.m.
(Make, type and size)

(b) Motor .....
(Type and horsepower)

14. Location of area irrigated or to be irrigated, or place of use if for purposes other than irrigation.

Township North or South	Range E. or W. of Willamette Meridian	Section	Forty-acre Tract	Number Acres To Be Irrigated	Date of Reclamation
T.4 South	R.3 West	2	SE 1/4 of the SW 1/4	16	1947

15. If the ground water supply is supplemental to an existing water supply, identification of any application for a permit, permit, certificate or adjudicated right to appropriate water made or held by the registrant.

.....

.....

Township 4 South Range 3 West, W.M.

North

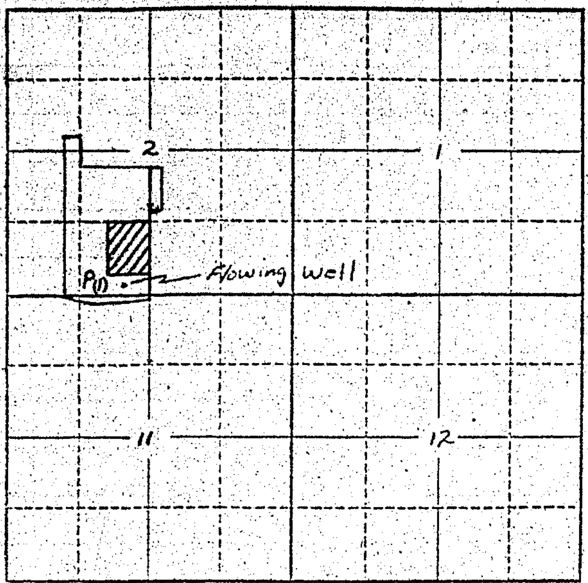

Locate well and acreage of irrigated land on plat.

Scale: 2" = 1 Mile

STATE OF OREGON
County of Yamhill } ss.

I, Phillip A. Hawman, being first duly sworn, do hereby certify that I have read the foregoing Registration Statement and that all of the items therein contained are true to the best of my knowledge and belief.

Phillip A. Hawman
(Signature of Registrant)

Subscribed and sworn to before me this 7th day of March ~~March~~, 19 57.

My commission expires Mar. 12, 1960 N. A. Cramer
(Notary Public)

(SEAL)

CERTIFICATE OF REGISTRATION

STATE OF OREGON
County of Marion } ss.

This is to certify that the foregoing Registration Statement was received in the office of the State Engineer on the 8th day of March, 19 57, at 11:00 o'clock A. M. and has been duly recorded in said office in Book No. 3 of Registration Statements on page GR-375 C.

~~Construction shall be completed by x-x-x-x-x-x-x-x-x, 19x-x, and the water completely applied to~~
~~beneficial use by x-x-x-x-x-x-x-x-x-x, 19-x-x-~~

Witness my hand this 30th day of April, 19 57

Lewis A. Stanley
(State Engineer)

$15.00

By
(Deputy)

GR 375 C