

Registration Statement

OF CLAIMANT OF RIGHT TO APPROPRIATE GROUND WATER

TO THE STATE ENGINEER OF OREGON:

I, Ernest Lear, Mayor of Condon and on behalf of said City

of Condon County of Gilliam

(Mailing address)

State of Oregon, do hereby make application for a certificate of registration as evidence of a right to appropriate ground water.

1. Source from which water is withdrawn is pump well #1
(Flowing well, pump well, infiltration trench, or tunnel)

2. Location is: NW corner of the City of Condon
(Approximate distance and direction from nearest city or town)

and is more particularly described as follows:

(a) 100 feet South and East from the Northwest corner of Section 10
(Give distance and bearing to corner of section or other legal subdivision)

being within NW 1/4 of Sec. 10, Twp. 4 South, Rge. 21 East
(Smallest legal subdivision) (N. or S.) (E. or W.)

or (b) within limits of recorded platted property, town or city: within City limits of Condon
 but on ground not platted.

in Lot _____, Block _____ of _____
(Name of plat or addition)

County of _____
(If within city or town, give name)

3. Construction Work was begun on 1906; was completed on 1906
(Date) (Date)

and the ground water claimed was first used for the purposes set out below on 1906
(Date)

since which time the water has been used intermittently
(Continuously or Intermittently)

from _____ to _____ (Has not been used in recent years.)
(Date) (Date)

4. Quantity of water claimed and used is 40 gallons per minute; _____ acre feet per year.

5. Purpose or Purposes for which water is used Municipal-City of Condon

(Domestic, irrigation, municipal, manufacturing, industrial, etc.)

6. Description of Well: Depth 410 feet. Type Drilled
(Dug or drilled)

diameter 6 inches. Elevation of ground at well site 2880 feet, mean sea level.
(As near as known)

Depth to water table 50 feet.

7. Capacity of Well: Do not know. g.p.m. with _____ feet drawdown.

_____ g.p.m. with _____ feet drawdown.

Date of test _____

If Flowing Well: Measured discharge _____ g.p.m. on _____
(Date)

Shut-in pressure at ground surface _____ lbs. per sq. in. on _____
(Date)

Water is controlled by _____
(Cap, valve, etc.)

If log of well is not available, give name and address of driller. Not known

11. Infiltration Trench: Covered or open

Dimensions: Length ft. Minimum depth ft. Maximum depth ft.

Bottom width ft. Discharge g.p.m. Date of test

12. Tunnel: Type of lining

Dimensions:
(Length, course, and cross sectional size)

Position of water bearing stratum with reference to portal of tunnel

Log of tunnel: (Preceding table for log of well may be used, if desired. Give footage from portal and character of materials, as pertinent.)

13. Pumping Equipment: None at present

(a) Pump Capacity g.p.m.
(Make, type and size)

(b) Motor
(Type and horsepower)


14. Location of area irrigated or to be irrigated, or place of use if for purposes other than irrigation.

Township North or South	Range E. or W. of Willamette Meridian	Section	Forty-acre Tract	Number Acres To Be Irrigated	Date of Reclamation
The City of Condon covers part or all of the following 40's within Sec. 10:					
4 South	21 E.	10	NW $\frac{1}{4}$ NW $\frac{1}{4}$		1906
"	"	"	NE $\frac{1}{4}$ NW $\frac{1}{4}$		
"	"	"	SW $\frac{1}{4}$ NW $\frac{1}{4}$		
"	"	"	SE $\frac{1}{4}$ NW $\frac{1}{4}$		
"	"	"	Part of NW $\frac{1}{4}$ NE $\frac{1}{4}$		
"	"	"	SW $\frac{1}{4}$ NE $\frac{1}{4}$		
"	"	"	Part of SE $\frac{1}{4}$ NE $\frac{1}{4}$		
"	"	"	NW $\frac{1}{4}$ SW $\frac{1}{4}$		
"	"	"	NE $\frac{1}{4}$ SW $\frac{1}{4}$		
"	"	"	SE $\frac{1}{4}$ SW $\frac{1}{4}$		
"	"	"	SW $\frac{1}{4}$ SE $\frac{1}{4}$		
"	"	"	NW $\frac{1}{4}$ SE $\frac{1}{4}$		
"	"	"	NE $\frac{1}{4}$ SE $\frac{1}{4}$		
"	"	"	SE $\frac{1}{4}$ SE $\frac{1}{4}$		
4 South	21 E.	3	Part of SW $\frac{1}{4}$ SW $\frac{1}{4}$		
"	"	"	Part of SE $\frac{1}{4}$ SW $\frac{1}{4}$		

15. If the ground water supply is supplemental to an existing water supply, identification of any application for a permit, permit, certificate or adjudicated right to appropriate water made or held by the registrant.

Township 4 South Range 21 East W.M.

North

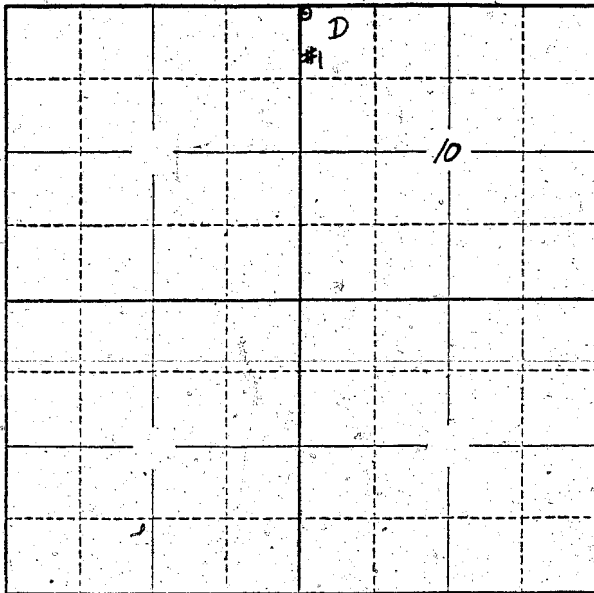

Locate well and acreage of irrigated land on plat.

Scale: 2" = 1 Mile

STATE OF OREGON

County of Gilliam

ss.

I, Ernest Lear, being first duly sworn, do hereby certify that I have read the foregoing Registration Statement and that all of the items therein contained are true to the best of my knowledge and belief.

(Signature of Registrant)

Subscribed and sworn to before me this 28 day of August, 1958.

My commission expires March 5, 1960.

(Notary Public)

(SEAL)

CERTIFICATE OF REGISTRATION

STATE OF OREGON

County of Marion

ss.

This is to certify that the foregoing Registration Statement was received in the office of the State Engineer on the 1st day of August, 1958, at 8:00 o'clock A.M. and has been duly recorded in said office in Book No. 15 of Registration Statements on page GR-3531

Witness my hand this 15th day of September, 1959

Lewis A. Stanley
(State Engineer)

By

(Deputy)

\$ 20.00

GR 3531