

# Registration Statement

## OF CLAIMANT OF RIGHT TO APPROPRIATE GROUND WATER

### TO THE STATE ENGINEER OF OREGON:

I, Milford C. Kennell

of Rt. 2, Box 464 B, Albany County of Linn  
(Mailing address)

State of Oregon, do hereby make application for a certificate of registration as evidence of a right to appropriate ground water.

1. Source from which water is withdrawn is Pump well  
(Flowing well, pump well, infiltration trench, or tunnel)
2. Location is: 4 miles East of Albany, Oregon  
(Approximate distance and direction from nearest city or town)

and is more particularly described as follows:

(a) 1914' S. and 1056' W. of NE corner S. 2, T. 11 S, R. 3 W.  
(Give distance and bearing to corner of section or other legal subdivision)

being within SE 1/4 of NE 1/4 of Sec. 2, Twp. 11 S, Rge. 3 W  
(Smallest legal subdivision) (N. or S.) (E. or W.)

or (b) within limits of recorded platted property, town or city:

in Lot \_\_\_\_\_, Block \_\_\_\_\_ of \_\_\_\_\_  
(Name of plat or addition)  
County of Linn  
(If within city or town, give name)

3. Construction Work was begun on July 1955; was completed on July 1955  
(Date) (Date)

and the ground water claimed was first used for the purposes set out below on July 1955  
(Date)

since which time the water has been used continuously  
(Continuously or intermittently)

from July 1955 to present time  
(Date) (Date)

4. Quantity of water claimed and used is 50 gallons per minute; 52.5 acre feet per year.

5. Purpose or Purposes for which water is used Irrigation

(Domestic, irrigation, municipal, manufacturing, industrial, etc.)

6. Description of Well: Depth 97 feet. Type Drilled  
(Dug or drilled)

diameter 10 inches. Elevation of ground at well site 220 feet, mean sea level.  
(As near as known)

Depth to water table 6 feet.

7. Capacity of Well: \_\_\_\_\_ g.p.m. with \_\_\_\_\_ feet drawdown.  
\_\_\_\_\_ g.p.m. with \_\_\_\_\_ feet drawdown.

Date of test Not tested

If Flowing Well: Measured discharge \_\_\_\_\_ g.p.m. on \_\_\_\_\_  
(Date)


Shut-in pressure at ground surface \_\_\_\_\_ lbs. per sq. in. on \_\_\_\_\_  
(Date)

Water is controlled by \_\_\_\_\_  
(Cap. valve, etc.)





Township 11S Range 3W W.M.  
North

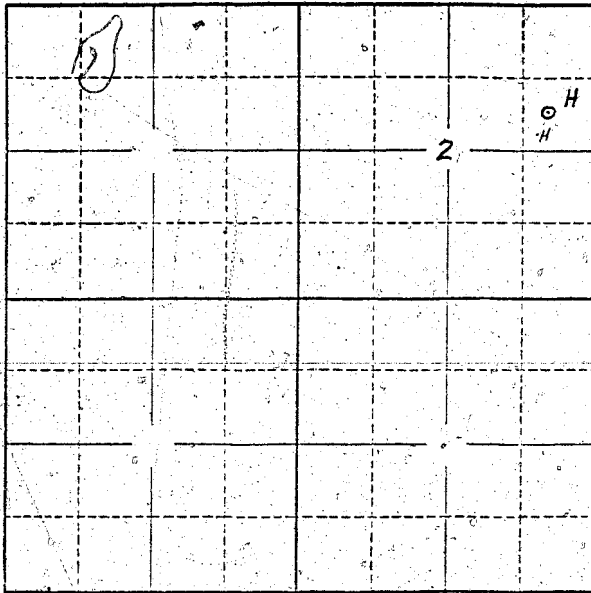

Locate well and acreage of irrigated land on plat.

Scale: 2" = 1 Mile

STATE OF OREGON

County of Linn

} ss.

I, Milford C. Kennell, being first duly sworn, do hereby certify that I have read the foregoing Registration Statement and that all of the items therein contained are true to the best of my knowledge and belief.

Milford C. Kennell  
(Signature of Registrant)

Subscribed and sworn to before me this 2<sup>nd</sup> day of August, 1957

My commission expires 4/15/60

W. P. ...  
(Notary Public)

(SEAL)

**CERTIFICATE OF REGISTRATION**

STATE OF OREGON

County of Marion

} ss.

This is to certify that the foregoing Registration Statement was received in the office of the State Engineer on the 4 day of August, 1958, at 10:07 o'clock A. M. and has been duly recorded in said office in Book No. 15 of Registration Statements on page GR 3531

Witness my hand this 15<sup>th</sup> day of September, 1959

Laura A. Atkinson  
(State Engineer)

By \_\_\_\_\_  
(Deputy)

#15.00

GR **3531**