

Registration Statement

OF CLAIMANT OF RIGHT TO APPROPRIATE GROUND WATER

TO THE STATE ENGINEER OF OREGON:

I, J. G. Jarnis
 of Eagle Camp Rd 1 Box 233 County of Clackamas
(Mailing address)
 State of _____, do hereby make application for a certificate of registration as evidence
 of a right to appropriate ground water.

1. Source from which water is withdrawn is Pump well
(Flowing well, pump well, infiltration trench, or tunnel)

2. Location is: 2 Miles North of Eagle Creek Oregon
(Approximate distance and direction from nearest city or town)

and is more particularly described as follows:

(a) 1000 Ft. W. 360 Ft. N. From the East 1/4 Cor. Sec. 29
(Give distance and bearing to corner of section or other legal subdivision)

being within S.E. 1/4 of N.E. 1/4 of Sec. 29, Twp. 2S, Rge. N.E.
(Smallest legal subdivision) of S. (E. or W.)

or (b) within limits of recorded platted property, town or city: _____

in Lot _____, Block _____ of _____
(Name of plat or addition)

County of _____
(If within city or town, give name)

3. Construction Work was begun on Aug 1st 55; was completed on Aug 31, 1955
(Date) (Date)

and the ground water claimed was first used for the purposes set out below on Sept 5, 1955
(Date)

since which time the water has been used intermittently
(Continuously or intermittently)

from 1955 to 1958
(Date) (Date)

4. Quantity of water claimed and used is 100 gallons per minute; _____ acre
 feet per year.

5. Purpose or Purposes for which water is used irrigation

(Domestic, irrigation, municipal, manufacturing, industrial, etc.)

6. Description of Well: Depth 20 feet. Type drilled
(Dug or drilled)

diameter 8 inches. Elevation of ground at well site _____ feet, mean sea level.
(As near as known)

Depth to water table _____ feet.

7. Capacity of Well: 100 g.p.m. with 80 feet drawdown.

_____ g.p.m. with _____ feet drawdown.


Date of test Aug 31, 1955

If Flowing Well: Measured discharge _____ g.p.m. on _____
(Date)

Shut-in pressure at ground surface _____ lbs. per sq. in. on _____
(Date)

Water is controlled by _____
(Cap, valve, etc.)

Township 25 Range 4E W.M.
North

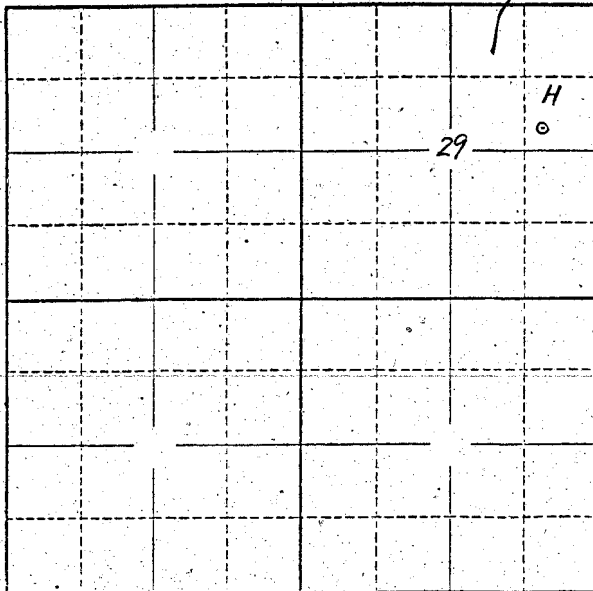

Locate well and acreage of irrigated land on plat.
Scale: 2" = 1 Mile

STATE OF OREGON

County of Marion } ss.

I, J. G. Jarvis, being first duly sworn, do hereby certify that I have read the foregoing Registration Statement and that all of the items therein contained are true to the best of my knowledge and belief.

J. G. Jarvis
(Signature of Registrant)

Subscribed and sworn to before me this 4th day of August, 19 58

My commission expires 12th June 1961 Wm. S. Bartholomew
(Notary Public)

(SEAL)

CERTIFICATE OF REGISTRATION

STATE OF OREGON

County of Marion } ss.

This is to certify that the foregoing Registration Statement was received in the office of the State Engineer on the 4th day of August, 19 58, at 8:30 o'clock A. M. and has been duly recorded in said office in Book No. 15 of Registration Statements on page GR-3536

Witness my hand this 15th day of September, 19 59

Lewis A. Stanley
(State Engineer)

By _____
(Deputy)

GR 3536

#15.15