

Registration Statement

OF CLAIMANT OF RIGHT TO APPROPRIATE GROUND WATER

TO THE STATE ENGINEER OF OREGON:

I, Sarah C. Zimmer

of 1904 N. E. 155 Ave. Portland 30 County of MULT.

State of ORE. do hereby make application for a certificate of registration as evidence of a right to appropriate ground water.

1. Source from which water is withdrawn is Well
(Flowing well, pump well, infiltration trench, or tunnel)

2. Location is: 650 feet east
(Approximate distance and direction from nearest city or town)

and is more particularly described as follows:

(a) 650 feet east & 950 feet north from SW corner Section 25
(Give distance and bearing to corner of section or other legal subdivision)

being within SW 1/4 PSE 1/4 of Sec. 25, Twp. 1N, Rge. 2E
(Smallest legal subdivision) (N. or S.) (E. or W.)

or (b) within limits of recorded platted property, town or city:

in Lot _____, Block _____ of _____
(Name of plat or addition)

County of _____
(If within city or town, give name)

3. Construction Work was begun on 1924, was completed on 1927
(Date) (Date)

and the ground water claimed was first used for the purposes set out below on 1927
(Date)

since which time the water has been used intermittently
(Continuously or intermittently)

from 1927 to Oct 1957
(Date) (Date)

4. Quantity of water claimed and used is 840 gallons per minute; _____ acre feet per year.

5. Purpose or Purposes for which water is used Irrigation

(Domestic, irrigation, municipal, manufacturing, industrial, etc.)

6. Description of Well: Depth 33 feet. Type Dug
(Dug or drilled)

diameter 37 inches. Elevation of ground at well site _____ feet, mean sea level.
(As near as known)

Depth to water table 30 feet.

7. Capacity of Well: _____ g.p.m. with _____ feet drawdown.

_____ g.p.m. with _____ feet drawdown.

Date of test No test

If Flowing Well: Measured discharge _____ g.p.m. on _____
(Date)

Shut-in pressure at ground surface _____ lbs. per sq. in. on _____
(Date)

Water is controlled by _____
(Cap, valve, etc.)

8. Casing: (Give diameter, commercial specifications and depth below ground surface of each casing size.)

37 inch diameter Concrete Pipe from 11 to 33 feet
 8 X 8 inch diameter Bored concrete box from 0 to 11 feet
 inch diameter from to feet
 inch diameter from to feet

Describe and show depth of shoe, plug, adapter, liner or other details:

9. Perforated Casings or Screens:

No from to
(Number per foot and size of perforations, or describe screen)
 from to
 from to
 from to

10. Log of Well: (Describe each stratum or formation clearly, indicate if water bearing, and give thickness and depth as indicated.)

MATERIAL	Thickness (Feet)	Depth to Bottom (Feet)
Top soil	0	3
gravel & sand small pea gravels	3	33

If log of well is not available, give name and address of driller. UNKNOWN

11. Infiltration Trench: Covered or open
Dimensions: Length ft. Minimum depth ft. Maximum depth ft.
Bottom width ft. Discharge g.p.m. Date of test

12. Tunnel: Type of lining
Dimensions:
(Length, course, and cross sectional size)
Position of water bearing stratum with reference to portal of tunnel

Log of tunnel: (Preceding table for log of well may be used, if desired. Give footage from portal and character of materials, as pertinent.)


13. Pumping Equipment:
(a) Pump Myers Ejecto Capacity 50 g.p.m.
(Make, type and size)
(b) Motor 1 HP Electric
(Type and horsepower)

14. Location of area irrigated or to be irrigated, or place of use if for purposes other than irrigation.

Township North or South	Range E. or W. of Willamette Meridian	Section	Forty-acre Tract	Number Acres To Be Irrigated	Date of Reclamation
<u>1N</u>	<u>2E</u>	<u>25</u>	<u>SW¹/₄ of SE¹/₄</u>	<u>2 1/2 AC</u>	<u>1927</u>

15. If the ground water supply is supplemental to an existing water supply, identification of any application for a permit, permit, certificate or adjudicated right to appropriate water made or held by the registrant.

Township 1N Range 2E, W.M.
North

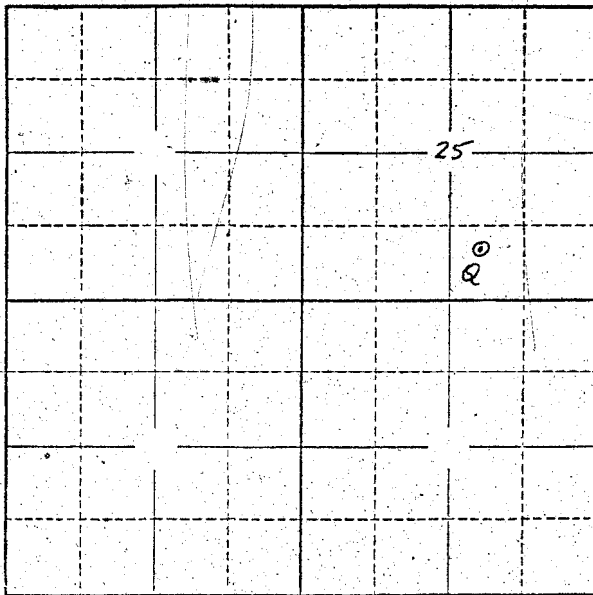

Locate well and acreage of irrigated land on plat.
Scale: 2" = 1 Mile

STATE OF OREGON

County of Marion } ss.

I, Sarah B. Zimmer, being first duly sworn, do hereby certify that I have read the foregoing Registration Statement and that all of the items therein contained are true to the best of my knowledge and belief.

Sarah B. Zimmer
(Signature of Registrant)

Subscribed and sworn to before me this 4th day of August, 19 58

My commission expires 12th June 1961 Wm. S. Bartholomew
(Notary Public)

(SEAL)

CERTIFICATE OF REGISTRATION

STATE OF OREGON

County of Marion } ss.

This is to certify that the foregoing Registration Statement was received in the office of the State Engineer on the 4th day of Aug, 19 58, at 10:45 o'clock A M. and has been duly recorded in said office in Book No. 15 of Registration Statements on page GR-3538

Witness my hand this 15th day of September, 19 59

Lura A. Stanley
(State Engineer)

\$ 15.00

By _____ (Deputy)

GR 3538