

OF CLAIMANT OF RIGHT TO APPROPRIATE GROUND WATER

(Under Chapter 708, Oregon Laws 1955.)

TO THE STATE ENGINEER OF OREGON:

I, Earl Farrier

of Route 1, Box 522, Albany County of Benton

State of Oregon do hereby make application for a certificate of registration as evidence of a right to appropriate ground water.

1. Source from which water is withdrawn is DWPT well (Flowing well, pump well, infiltration trench, or tunnel)

2. Location is: 6 miles north of Albany (Approximate distance and direction from nearest city or town)

and is more particularly described as follows: 158' N. 77° 10' west of SE corner of lot, 1550 feet north & 320 feet east from SW cor. Section 14, (a) said corner located with 1 1/2" shaft located in Sec. 14, T. 10S., R. 4W., W. 1/4

being within NW 1/4 of SW 1/4 of Sec. 14, Twp. 10S., Rge. 4W (Smallest legal subdivision) (N. or S.) (E. or W.)

or (b) within limits of recorded platted property, town or city:

in Lot Block of (Name of plat or addition)

County of (If within city or town, give name)

3. Construction Work was begun on 1953 (Date); was completed on 1954 (Date)

and the ground water claimed was first used for the purposes set out below on 1954 (Date)

since which time the water has been used continuously (Continuously or intermittently)

from 1954 (Date) to 1957 (Date)

4. Quantity of water claimed and used is 75 gallons per minute; 10 acre feet per year.

5. Purpose or Purposes for which water is used irrigation (Domestic, irrigation, municipal, manufacturing, industrial, etc.)

6. Description of Well: Depth 36 feet. Type drilled (Dug or drilled)

diameter 8 inches. Elevation of ground at well site 210 feet, mean sea level. (As near as known)

Depth to water table 20 feet.

7. Capacity of Well: 135 g.p.m. with 10 feet drawdown. g.p.m. with feet drawdown.

Date of test

If Flowing Well: Measured discharge g.p.m. on (Date)

Shot-in pressure at ground surface lbs. per sq. in. on (Date)

Water is controlled by (Cap, valve, etc.)

8. Casing: (Give diameter, commercial specifications and depth below ground surface of each casing size.)

8	inch diameter	from surface	to 36	feet
	inch diameter	from	to	feet
	inch diameter	from	to	feet
	inch diameter	from	to	feet

Describe and show depth of shoe, plug, adapter, liner or other details:

9. Perforated Casings or Screens:

number and size unknown	from 26'	to 36'
<small>(Number per foot and size of perforations, or describe screen)</small>	from	to
	from	to
	from	to

10. Log of Well: (Describe each stratum or formation clearly, indicate if water bearing, and give thickness and depth as indicated.)

MATERIAL	Thickness (Feet)	Depth to Bottom (Feet)

If log of well is not available, give name and address of driller.

Art Clinton, Independence

11. Infiltration Trench: Covered or open
 Dimensions: Length ft. Minimum depth ft. Maximum depth ft.

Bottom width ft. Discharge g.p.m. Date of test

12. Tunnel: Type of lining
 Dimensions:
 (Length, course, and cross sectional size)

Position of water bearing stratum with reference to portal of tunnel

Log of tunnel: (Preceding table for log of well may be used, if desired. Give footage from portal and character of materials, as pertinent.)

13. Pumping Equipment:

(a) Pump Fairbanks Morse turbine Capacity 75 g.p.m.
 (Make, type and size)


(b) Motor 7 1/2 hp 3 phase electric
 (Type and horsepower)

14. Location of area irrigated or to be irrigated, or place of use if for purposes other than irrigation.

Township North or South	Range E. or W. of Willamette Meridian	Section	Forty-acre Tract	Number Acres To Be Irrigated	Date of Reclamation
10S	4W	14	SW 1/4 SW 1/4	3.5	1954
10S	4W	14	NW 1/4 SW 1/4	8.0	1954
10S	4W	15	SE 1/4 SE 1/4	7.0	1954
10S	4W	15	NE 1/4 SE 1/4	5.5	1954
				<u>24.0</u>	

15. If the ground water supply is supplemental to an existing water supply, identification of any application for a permit, permit, certificate or adjudicated right to appropriate water made or held by the registrant.

Township 10.5 Range 4 W., W.M.
North

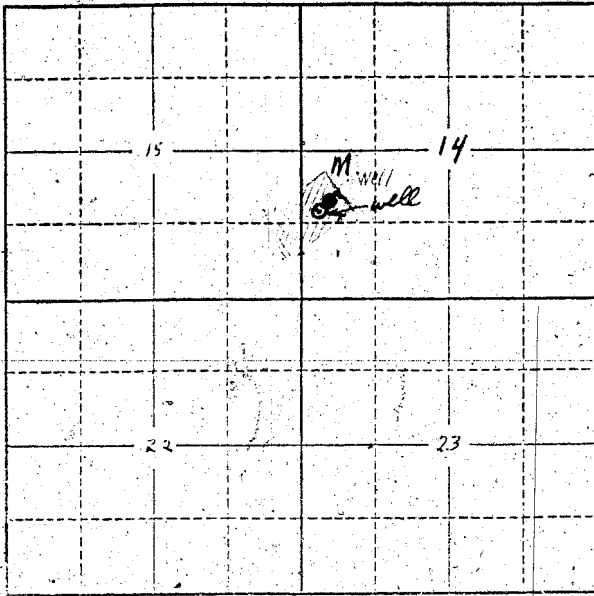

Locate well and acreage of irrigated land on plat.
Scale: 2" = 1 Mile

STATE OF OREGON

County of

ss.

I,, being first duly sworn, do hereby certify that I have read the foregoing Registration Statement and that all of the items therein contained are true to the best of my knowledge and belief.

Earl Farnier
(Signature of Registrant)

Subscribed and sworn to before me this 1 day of August, 1958

My commission expires

MY COMMISSION EXPIRES MAY 26, 1960

Lillian E. Phillips
(Notary Public)

(SEAL)

CERTIFICATE OF REGISTRATION

STATE OF OREGON

County of Marion

ss.

This is to certify that the foregoing Registration Statement was received in the office of the State Engineer on the 4 day of August, 1958, at 8:00 o'clock A. M. and has been duly recorded in said office in Book No. 15 of Registration Statements on page GR-3541

~~xx Certificate shall be completed by and the certain receipt applied xx
transmission by xx~~

Witness my hand this 15th day of September, 1959

Laura A. Stanley
(State Engineer)

By

(Deputy)

GR-3541

#15.00