

RECEIVED

MAY 3 1950

STATE ENGINEER
SALEM, OREGON

REGISTRATION NO. GR-390

Registration Statement

CERTIFICATE NO. GR-625

OF CLAIMANT OF RIGHT TO APPROPRIATE GROUND WATER

(Under Chapter 708, Oregon Laws 1955.)

TO THE STATE ENGINEER OF OREGON:

I, Albany Food Products, Inc.

of Albany, Oregon County of Linn

State of Oregon, do hereby make application for a certificate of registration as evidence of a right to appropriate ground water.

1. Source from which water is withdrawn is Pump Well

(Flowing well, pump well, infiltration trench, or tunnel)

2. Location is: One half mile South of Albany Oregon

(Approximate distance and direction from nearest city or town)

and is more particularly described as follows: approx. 2393 ft. north & 585' west from SE corner section 13

(a) Ten feet SE of SE Corner of AFP Process Building

NE 1/4 of the SE 1/4 (Give distance and bearing to corner, section or other legal subdivision)

being within 30th Street of Sec. 9, Twp. 11S, Rge. 4E W

(Smallest legal subdivision)

(N. or S.)

(E. or W.)

or (b) within limits of recorded platted property, town or city: Albany Oregon

in Lot Not Divided of 745 W 30th Street Albany, Oregon

(Name of plat or addition)

Albany County of Linn

(If within city or town, give name)

3. Construction Work was begun on June 1949; was completed on June 1949

(Date)

(Date)

and the ground water claimed was first used for the purposes set out below on June 1949

(Date)

since which time the water has been used Continuously

(Continuously or Intermittently)

from 1949 to 1957

(Date)

(Date)

4. Quantity of water claimed and used is 25 when used gallons per minute; acre feet per year.

5. Purpose or Purposes for which water is used Commercial Food Processing

(Domestic, irrigation, municipal, manufacturing, industrial, etc.)

6. Description of Well: Depth 42 Ft. ? feet. Type Drilled

(Dug or drilled)

diameter 12 inches. Elevation of ground at well site 113 feet, mean sea level.

(As near as known)

Depth to water table 13 feet.

7. Capacity of Well: g.p.m. with feet drawdown.

 g.p.m. with feet drawdown.

Date of test

If Flowing Well: Measured discharge g.p.m. on (Date)

Shut-in pressure at ground surface lbs. per sq. in. on (Date)

Water is controlled by (Cap, valve, etc.)

8. Casing: (Give diameter, commercial specifications and depth below ground surface of each casing size.)

12 or ~~14~~ inch diameter from ~~14~~ 0 to 42 feet
 inch diameter from to feet
 inch diameter from to feet
 inch diameter from to feet

Describe and show depth of shoe, plug, adapter, liner or other details:


.....

.....

9. Perforated Casings or Screens:


unknown from to
 (Number per foot and size of perforations, or describe screen) *
 from to
 from to
 from to

10. Log of Well: (Describe each stratum or formation clearly, indicate if water-bearing, and give thickness and depth, as indicated.)
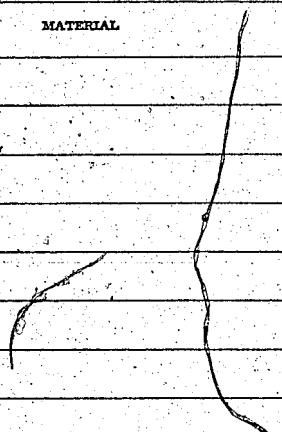
| MATERIAL | Thickness (Feet) | Depth to Bottom (Feet) |
|----------------|--|------------------------|
| <i>unknown</i> |  | |
| | | |
| | | |
4W

Township 11 S Range 4 W W.M.
North

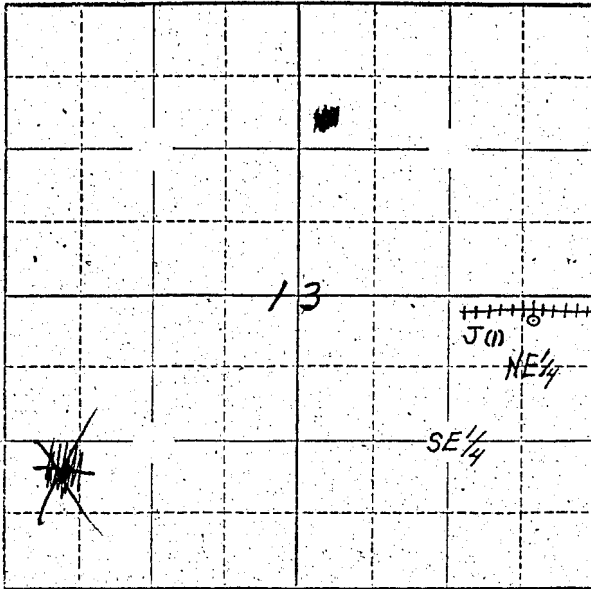

Locate well and acreage of irrigated land on plat.

Scale: ■ = 1 Mile
4"

STATE OF OREGON

County of Linn } ss.

I, [Signature], being first duly sworn, do hereby certify that I have read the foregoing Registration Statement and that all of the items therein contained are true to the best of my knowledge and belief.

Subscribed and sworn to before me this 27th day of March, 1957

My commission expires May 26, 1958 [Signature]
(Notary Public)

(SEAL)

CERTIFICATE OF REGISTRATION

STATE OF OREGON

County of Marion } ss.

This is to certify that the foregoing Registration Statement was received in the office of the State Engineer on the 8th day of March, 1957, at 8:00 o'clock A. M. and has been duly recorded in said office in Book No. 4 of Registration Statements on page GR-625 C.

~~Construction has been completed by [scribble] and the water completely applied to [scribble]~~

Witness my hand this 27th day of November, 1957

LEWIS A. STANLEY
(State Engineer)

By [Signature]
(Deputy)

\$ 20.⁰⁰

GR-625 C