

# Registration Statement

## OF CLAIMANT OF RIGHT TO APPROPRIATE GROUND WATER

**TO THE STATE ENGINEER OF OREGON:**

I, Stephen Kane  
of 2705 South Highway 99, Grants Pass County of Josephine  
(Mailing address)  
State of Oregon, do hereby make application for a certificate of registration as evidence of a right to appropriate ground water.

1. Source from which water is withdrawn is pond well  
(Flowing well, pump well, infiltration trench, or tunnel)

2. Location is: 3 1/2 miles east of Grants Pass on Highway 99 South  
(Approximate distance and direction from nearest city or town)

and is more particularly described as follows:

(a) 290 ft. South and 15 ft. East of quarter corner sect 23  
(Give distance and bearing to corner of section or other legal subdivision)

being within N 1/4 of S W 1/4 of Sec. 23, Twp. 36 So., Rge. 5 East  
(Smallest legal subdivision) (N. or S.) (E. or W.)

or (b) within limits of recorded platted property, town or city:

in Lot \_\_\_\_\_, Block \_\_\_\_\_ of \_\_\_\_\_  
(Name of plat or addition)

\_\_\_\_\_ County of \_\_\_\_\_  
(If within city or town, give name)

3. Construction Work was begun on 1948; was completed on 1948  
(Date) (Date)

and the ground water claimed was first used for the purposes set out below on 1948  
(Date)

since which time the water has been used continuously  
(Continuously or intermittently)

from 1948 to Present  
(Date) (Date)

4. Quantity of water claimed and used is approx. 1500 gallons per minute, 24 hr. period  
well has never been measured to my knowledge. has been run 10 hrs  
per day 365 days per year & has never gone dry.  
feet per year

5. Purpose or Purposes for which water is used Domestic and manufacturing trout & maintaining trout ponds, including large pond for public fishing. This pond discharges to lower Grants Pass irrigation canal.  
Commercial uses

6. Description of Well: Depth 85 feet. Type drilled  
(Dug or drilled)

diameter 6 inches. Elevation of ground at well site approx. 1,000 feet, mean sea level.  
(As near as known)

Depth to water table unknown feet.

7. Capacity of Well: See #4 above. g.p.m. with \_\_\_\_\_ feet drawdown.

See #4 above. g.p.m. with \_\_\_\_\_ feet drawdown.

Date of test See #4 above.

If Flowing Well: Measured discharge \_\_\_\_\_ g.p.m. on \_\_\_\_\_  
(Date)


Shut-in pressure at ground surface \_\_\_\_\_ lbs. per sq. in. on \_\_\_\_\_  
(Date)

Water is controlled by \_\_\_\_\_  
(Cap, valve, etc.)





Township 36 S Range 5 W W.M.  
North

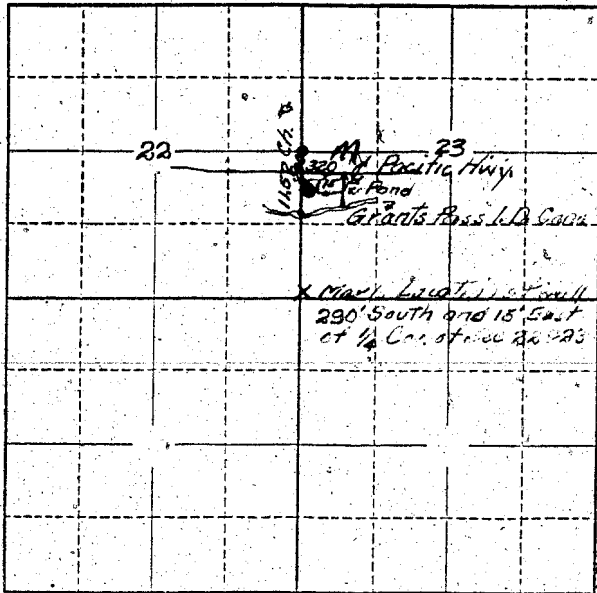

Locate well and acreage of irrigated land on plat.  
Scale: 2" = 1 Mile

STATE OF OREGON

County of Josephine } ss.

I, Stephen Kave, being first duly sworn, do hereby certify that I have read the foregoing Registration Statement and that all of the items therein contained are true to the best of my knowledge and belief.

*Stephen Kave*  
(Signature of Registrant)

Subscribed and sworn to before me this 2 day of August, 1955

My commission expires May 10, 1962 James A. Clark  
(Notary Public)

(SEAL)

CERTIFICATE OF REGISTRATION

STATE OF OREGON

County of Marion } ss.

This is to certify that the foregoing Registration Statement was received in the office of the State Engineer on the 4th day of August, 1955, at 2:00 o'clock P.M. and has been duly recorded in said office in Book No. 15 of Registration Statements on page GR-3543

Witness my hand this 15th day of September, 1959

*Lawrence A. Stanley*  
(State Engineer)

By \_\_\_\_\_ (Deputy)

\$ 20.00

GR 3543