

Registration Statement

OF CLAIMANT OF RIGHT TO APPROPRIATE GROUND WATER

TO THE STATE ENGINEER OF OREGON:

I, Fredrick E. Hess
of Box 3 Veneta County of Lane
(Mailing address)

State of Oregon, do hereby make application for a certificate of registration as evidence of a right to appropriate ground water.

1. Source from which water is withdrawn is Flowing well
(Flowing well, pump well, infiltration trench, or tunnel)

2. Location is: 11 miles
(Approximate distance and direction from nearest city or town)

and is more particularly described as follows: in NE corner of SE 1/4 of NE 1/4 or E 1/4 corner.

(a) 338 ft north to corner of section
(Give distance and bearing to corner of section or other legal subdivision)

being within Sec. 31 Twp. 17-S Rge. 5 W
(Smallest legal subdivision) (S. or S.) (E. or W.)

or (b) within limits of recorded platted property, town or city:

in Lot _____, Block _____ of _____
(Name of plat or addition)

County of _____
(If within city or town, give name)

3. Construction Work was begun on April 1946, was completed on April 1946
(Date) (Date)

and the ground water claimed was first used for the purposes set out below on May 1946
(Date)

since which time the water has been used Continuously
(Continuously or Intermittently)

from 1946 to 1958
(Date) (Date)

4. Quantity of water claimed and used is 80 gallons per minute; _____ acre feet per year.

5. Purpose or Purposes for which water is used irrigation

(Domestic, irrigation, municipal, manufacturing, industrial, etc.)

6. Description of Well: Depth 86 feet. Type _____
(Dug or drilled)

diameter 6" inches. Elevation of ground at well site _____ feet, mean sea level.
(As near as known)

Depth to water table 23 feet.

7. Capacity of Well: _____ g.p.m. with _____ feet drawdown.

_____ g.p.m. with _____ feet drawdown.


Date of test No test on well drilled 3-14

If Flowing Well: Measured discharge _____ g.p.m. on _____
(Date)

Shut-in pressure at ground surface _____ lbs. per sq. in. on _____
(Date)

Water is controlled by _____
(Cap, valve, etc.)

Township 17S Range 5W W.M.
North

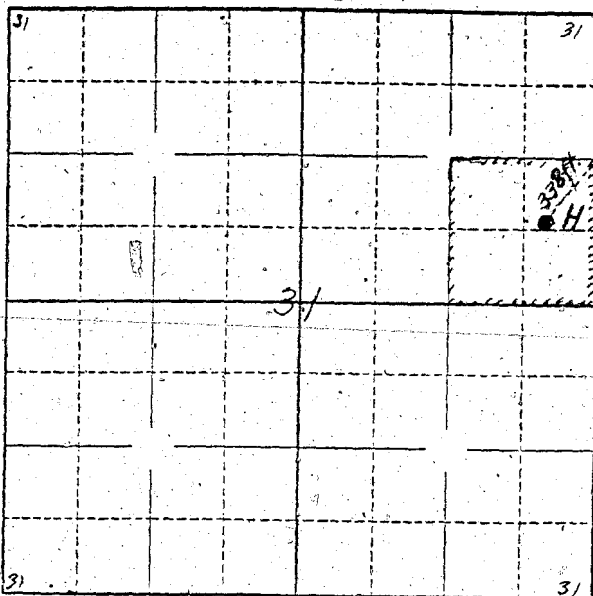

Locate well and acreage of irrigated land on plat.

Scale: $\frac{1}{4}$ " = 1 Mile

STATE OF OREGON

County of Lane } ss.

Frederick E. Hess, being first duly sworn, do hereby certify that I have read the foregoing Registration Statement and that all of the items therein contained are true to the best of my knowledge and belief.

Frederick E. Hess
(Signature of Registrant)

Subscribed and sworn to before me this 29 day of July, 1958

My commission expires MISSION EXPIRES JULY 28, 1959

Edith C. C.
(Notary Public)

(SEAL)

CERTIFICATE OF REGISTRATION

STATE OF OREGON } ss.
County of Marion

This is to certify that the foregoing Registration Statement was received in the office of the State Engineer on the 4 day of August, 1958, at 9:00 o'clock A. M. and has been duly recorded in said office in Book No. 15 of Registration Statements on page GR-3545.

Witness my hand this 15th day of September, 1959

Lewis A. Stanley
(State Engineer)

By _____ (Deputy)

GR 3545

4/16/50