

State Engineer
Linn County Oregon

Registration No. GR. 3905
Certificate No. GR - 3546

Registration Statement

OF CLAIMANT OF RIGHT TO APPROPRIATE GROUND WATER

TO THE STATE ENGINEER OF OREGON:

I, Earl J. Perry
of NE 3/4 Sec 335 Oregon County of Linn
(Mailing address)

State of Oregon, do hereby make application for a certificate of registration as evidence of a right to appropriate ground water.

1. Source from which water is withdrawn is Temp well
(Flowing well, pump well, infiltration trench, or tunnel)
2. Location is: five & one half miles North East of Oregon
(Approximate distance and direction from nearest city or town)

and is more particularly described as follows:

(a) 1430 ft North and 1422 ft East S.E. corner
(Give distance and bearing to corner of section or other legal subdivision)
being within NE 1/4 of SW 1/4 of Sec. 10, Twp. 17 South, Rge. 3 West
(Smallest legal subdivision) (N. or S.) (E. or W.)

or (b) within limits of recorded platted property, town or city:
in Lot _____ Block _____ of _____
(Name of plat or addition)

County of Linn
(If within city or town, give name)

3. Construction Work was begun on _____; was completed on 1943
(Date) (Date)

and the ground water claimed was first used for the purposes set out below on 1945
(Date)

since which time the water has been used Continuously
(Continuously or intermittently)
from 1945 to 1958
(Date) (Date)

4. Quantity of water claimed and used is 120 gallons per minute; 10 acre feet per year;

5. Purpose or Purposes for which water is used Irrigation
(Domestic, irrigation, municipal, manufacturing, industrial, etc.)

6. Description of Well: Depth 20 feet. Type open
(Dug or drilled)

diameter 22 inches. Elevation of ground at well site _____ feet, mean sea level.
(As near as known)

Depth to water table 11 feet.

7. Capacity of Well: 120 g.p.m. with 76 feet drawdown.
_____ g.p.m. with _____ feet drawdown.


Date of test Sept 21 1958

If Flowing Well: Measured discharge _____ g.p.m. on _____
(Date)

Shut-in pressure at ground surface _____ lbs. per sq. in. on _____
(Date)

Water is controlled by _____
(Cap, valve, etc.)

Township 17 South Range 3 West, W.M.
North

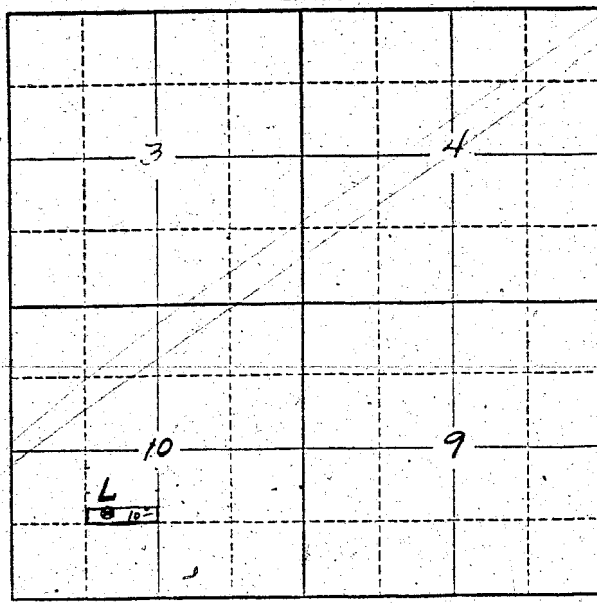

Locate well and acreage of irrigated land on plat.
Scale: 2" = 1 Mile

STATE OF OREGON }
County of Linn } ss.

I, Paul J. [Signature], being first duly sworn, do hereby certify that I have read the foregoing Registration Statement and that all of the items therein contained are true to the best of my knowledge and belief.

[Signature]
(Signature of Registrant)

Subscribed and sworn to before me this 31 day of July, 1959

My commission expires 7.29.1960
[Signature]
(Notary Public)

(SEAL)

CERTIFICATE OF REGISTRATION

STATE OF OREGON }
County of Marion } ss.

This is to certify that the foregoing Registration Statement was received in the office of the State Engineer on the 4th day of August, 1957, at 2:00 o'clock A. M. and has been duly recorded in said office in Book No. 15 of Registration Statements on page GR-3546

Witness my hand this 15th day of September, 1959
Lewis A. Stanley
(State Engineer)

\$15.00

By _____
(Deputy)

GR 3546