

Registration Statement

OF CLAIMANT OF RIGHT TO APPROPRIATE GROUND WATER

TO THE STATE ENGINEER OF OREGON:

I, Ernest W. Pruitt
of Ernest W. Pruitt County of Linn Co.
(Mailing address)
State of Oregon, do hereby make application for a certificate of registration as evidence of a right to appropriate ground water.

1. Source from which water is withdrawn is Flowing well
(Flowing well, pump well, infiltration trench, or tunnel)
2. Location is: Four and a half miles W.E. of Eugene
(Approximate distance and direction from nearest city or town)

and is more particularly described as follows:

(a) Flow well located 36' in diameter
SE 1/4 NE 1/4 (Give distance and bearing to corner of section or other legal subdivision)
being within 24' S. of 15' N. 1/4 of Sec. 16 Twp. 17S, Rge. R. 3 W. N. M.
(Smallest legal subdivision) (N. or S.) (E. or W.)

or (b) within limits of recorded platted property, town or city:

in Lot _____, Block _____ of _____
(Name of plat or addition)
County of _____
(If within city or town, give name)

3. Construction Work was begun on June 10 1938 was completed on Sept 20 1938
(Date) (Date)
and the ground water claimed was first used for the purposes set out below on June 10 1938
(Date)
since which time the water has been used Continuously
(Continuously or intermittently)

from irrigation to domestic use
(Date) (Date)

4. Quantity of water claimed and used is 150 gal gallons per minute; _____ acre feet per year.

5. Purpose or Purposes for which water is used Irrigation only
(Domestic, irrigation, municipal, manufacturing, industrial, etc.)

6. Description of Well: Depth Eleven feet. Type Open dug
(Dug or drilled)
diameter 36 in inches. Elevation of ground at well site 1000 feet, mean sea level.
(As near as known)
Depth to water table 10 feet.

7. Capacity of Well: 150 gal g.p.m. with _____ feet drawdown.
_____ g.p.m. with _____ feet drawdown.

Date of test _____

If Flowing Well: Measured discharge _____ g.p.m. on _____
(Date)

Shut-in pressure at ground surface _____ lbs. per sq. in. on _____
(Date)

Water is controlled by open well pump
(Cap, valve, etc.)

8. Casing: (Give diameter, commercial specifications and depth below ground surface of each casing size.)

..... inch diameter from to feet

..... inch diameter from to feet

..... inch diameter from to feet

..... inch diameter from to feet

Describe and show depth of shoe, plug, adapter, liner or other details:

.....

.....

9. Perforated Casings or Screens:

..... from to
(Number per foot and size of perforations, or describe screen)

..... from to

..... from to

..... from to

10. Log of Well: (Describe each stratum of formation clearly, indicate if water bearing, and give thickness and depth as indicated.)

| MATERIAL | Thickness (Feet) | Depth to Bottom (Feet) |
|----------|---------------------|---------------------------|
| | | |
| | | |
If log of well is not available, give name and address of driller: _____

11. **Infiltration Trench:** Covered or open _____

Dimensions: Length _____ ft. Minimum depth _____ ft. Maximum depth _____ ft.

Bottom width _____ ft. Discharge _____ g.p.m. Date of test _____

12. **Tunnel:** Type of lining _____

Dimensions: _____
(Length, course, and cross sectional size).

Position of water bearing stratum with reference to portal of tunnel _____

Log of tunnel: (Preceding table for log of well may be used, if desired. Give footage from portal and character of materials, as pertinent.)

13. **Pumping Equipment:**

(a) Pump *Fairbanks Morse motor pump.* Capacity *150* g.p.m.
(Make, type and size)

(b) Motor *wind pump direct current motor 75 H.P.*
(Type and horsepower)
4 in high pressure pump, Fairbanks


14. **Location of area irrigated or to be irrigated, or place of use if for purposes other than irrigation.**

| Township North or South | Range E. or W. of Willamette Meridian | Section | Forty-acre Tract | Number Acres To Be Irrigated | Date of Reclamation |
|----------------------------|--|---------------|-------------------------|---------------------------------|------------------------|
| <i>17 S</i> | <i>3 W. 2d. Mer.</i> | <i>16 + 2</i> | <i>SE 1/4 of NE 1/4</i> | <i>28.0</i> | <i>Jan-1-1939</i> |
| | | | | | |
| | | | | | |
15. If the ground water supply is supplemental to an existing water supply, identification of any application for a permit, permit, certificate or adjudicated right to appropriate water made or held by the registrant.

Township 17. S Range R. 3 W.M.

North

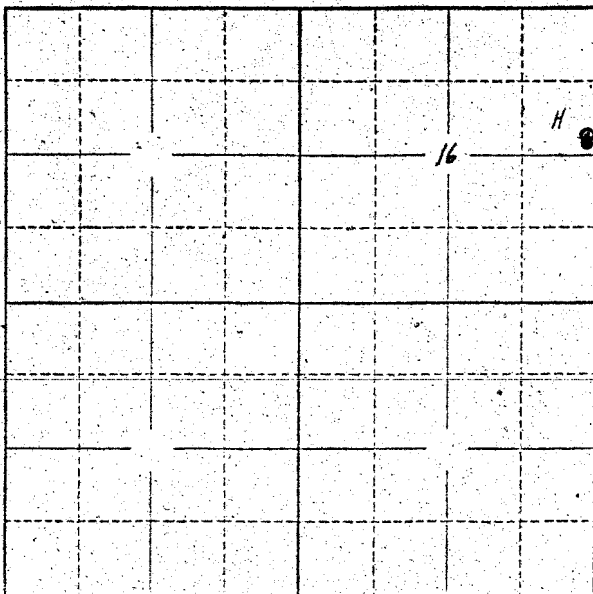

Locate well and acreage of irrigated land on plat.

Scale: 2" = 1 Mile

STATE OF OREGON

County of Lane

} ss.

I, _____ being first duly sworn, do hereby certify that I have read the foregoing Registration Statement and that all of the items therein contained are true to the best of my knowledge and belief.

Ellen Marie Pruitt
(Signature of Registrant)

Subscribed and sworn to before me this 1st day of August, 1958.

My commission expires

NOTARY PUBLIC FOR OREGON
My Commission Expires Oct. 16, 1959

Robert G. Inver
(Notary Public)

(SEAL)

CERTIFICATE OF REGISTRATION

STATE OF OREGON

County of Marion

} ss.

This is to certify that the foregoing Registration Statement was received in the office of the State Engineer on the 4th day of August, 1958, at 2:00 o'clock A.M. and has been duly recorded in said office in Book No. 15 of Registration Statements on page GR 3551

Witness my hand this 15th day of September

Laura A. Stanley
(State Engineer)

1/5.20

By _____
(Deputy)

GR 3551