

Registration Statement

OF CLAIMANT OF RIGHT TO APPROPRIATE GROUND WATER

TO THE STATE ENGINEER OF OREGON:

I, HOMER W. EGAN
of Brooks, Oregon County of Marion
(Mailing address)
State of Oregon, do hereby make application for a certificate of registration as evidence of a right to appropriate ground water.

1. Source from which water is withdrawn is pump well
(Flowing well, pump well, infiltration trench, or tunnel)

2. Location is: 9 miles north of Salem, Oregon
(Approximate distance and direction from nearest city or town)

and is more particularly described as follows:

(a) Well is S77°54'E 1915.54 feet and S15°05'W 209 feet from SW Cor. of Albright DLC62
(Give distance and bearing to corner of section or other legal subdivision)
being within J.J. Lemmon DLC 63 of Sec. 7, Twp. 6 South, Rge. 2 West
(Smallest legal subdivision) (N. or S.) (E. or W.)

or (b) within limits of recorded platted property, town or city:

in Lot _____, Block _____ of _____
(Name of plat or addition)

County of _____
(If within city or town, give name)

3. Construction Work was begun on Oct. 17, 1950; was completed on Oct. 30, 1950
(Date) (Date)

and the ground water claimed was first used for the purposes set out below on Nov. 1, 1950; June 1952
(Date)

since which time the water has been used continuously for domestic and floriculture &
(Continuously or intermittently)

from June to October each year for irrigation, the latter since 1952.
(Date) (Date)

4. Quantity of water claimed and used is 145.86 gallons per minute; _____ acre feet per year.

5. Purpose or Purposes for which water is used domestic, floriculture and irrigation

(Domestic, irrigation, municipal, manufacturing, industrial, etc.)

6. Description of Well: Depth 117 feet. Type drilled
(Dug or drilled)

diameter 8 inches. Elevation of ground at well site 210 feet, mean sea level.
(As near as known)

Depth to water table 25 feet.

7. Capacity of Well: 145 g.p.m. with 10 feet drawdown.

180 g.p.m. with 55-60 feet drawdown.


Date of test October 27-30, 1950

If Flowing Well: Measured discharge _____ g.p.m. on _____
(Date)

Shut-in pressure at ground surface _____ lbs. per sq. in. on _____
(Date)

Water is controlled by _____
(Cap, valve, etc.)

Township 6 South Range 2 West, W.M.
North

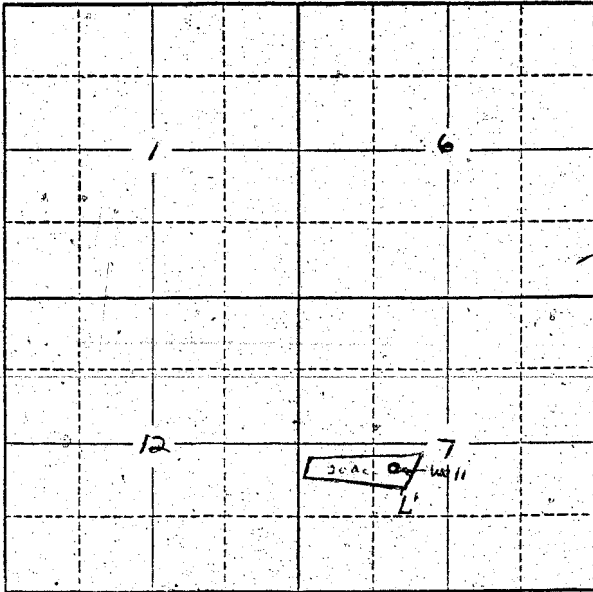

Locate well and acreage of irrigated land on plat.
Scale: 2" = 1 Mile

STATE OF OREGON

County of Marion } ss.

I, Homer W. Egan, being first duly sworn, do hereby certify that I have read the foregoing Registration Statement and that all of the items therein contained are true to the best of my knowledge and belief.

Homer W. Egan
(Signature of Registrant)

Subscribed and sworn to before me this 31st day of July, 1958

My commission expires Oct. 28, 1960
Cedric L. Egan
(Notary Public)

(SEAL)

CERTIFICATE OF REGISTRATION

STATE OF OREGON

County of Marion } ss.

This is to certify that the foregoing Registration Statement was received in the office of the State Engineer on the 4 day of August, 1958, at 8:00 o'clock A. M. and has been duly recorded in said office in Book No. 15 of Registration Statements on page GR-3552

Witness my hand this 15th day of September, 1959

Lewis A. Stanley
(State Engineer)

\$15.00

By _____ (Deputy)

GR 3552