

# Registration Statement

## OF CLAIMANT OF RIGHT TO APPROPRIATE GROUND WATER

TO THE STATE ENGINEER OF OREGON:

I, INTERLACHEN, INC  
 of RT. 2, BOX 289, TRUETTDALE County of MULTNOMAH  
 State of OREGON, do hereby make application for a certificate of registration as evidence  
 of a right to appropriate ground water.

1. Source from which water is withdrawn is PUMP WELL  
(Flowing well, pump well, infiltration trench, or tunnel)
2. Location is: 1 1/2 MILES NORTH OF FAIRVIEW  
(Approximate distance and direction from nearest city or town)

and is more particularly described as follows:

(a) 250 feet west of 1200 feet north from south 1/4 corner Section 21  
(Give distance and bearing to corner of section or other legal subdivision)  
 being within SE 1/4 of SW 1/4 of Sec. 21, Twp. 1N, Rge. 3E  
(Smallest legal subdivision) (N. S. E.)  
 or (b) within limits of recorded platted property, town or city:  
 in Lot 5, Block \_\_\_\_\_ of FAIRVIEW COUNTRY CLUB TRACTS  
(Name of plat or addition)  
 County of MULTNOMAH  
(If within city or town, give name)

3. Construction Work was begun on APRIL 1942; was completed on APRIL 1942  
(Date) (Date)  
 and the ground water claimed was first used for the purposes set out below on APRIL 1942  
(Date)  
 since which time the water has been used CONTINUOUSLY  
(Continuously or intermittently)  
 from APRIL 1942 to TODATE  
(Date) (Date)

4. Quantity of water claimed and used is 30 gallons per minute; \_\_\_\_\_ acre  
 feet per year.

5. Purpose or Purposes for which water is used MUNICIPAL  
(Domestic, irrigation, municipal, manufacturing, industrial, etc.)

6. Description of Well: Depth 10.9 feet. Type DRILLED  
(Dug or drilled)  
 diameter 8 inches. Elevation of ground at well site \_\_\_\_\_ feet, mean sea level.  
(As near as known)  
 Depth to water table 11 feet.

7. Capacity of Well: 3.3 g.p.m. with 59 feet drawdown.  
5.9 g.p.m. with 10.4 feet drawdown.

Date of test MARCH 30, 1955

If Flowing Well: Measured discharge \_\_\_\_\_ g.p.m. on \_\_\_\_\_  
(Date)


Shut-in pressure at ground surface \_\_\_\_\_ lbs. per sq. in. on \_\_\_\_\_  
(Date)

Water is controlled by \_\_\_\_\_  
(Cap, valve, etc.)





Township 1N Range 3E, W.M.  
North

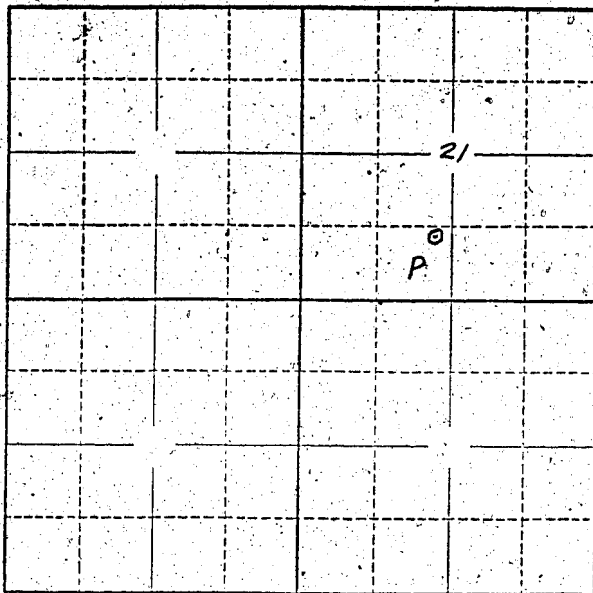

Locate well and acreage of irrigated land on plat.  
Scale: 2" = 1 Mile

STATE OF OREGON

County of Multnomah } ss.

I, A. Lloyd McMillen being first duly sworn, do hereby certify that I have read the foregoing Registration Statement and that all of the items therein contained are true to the best of my knowledge and belief.

A. Lloyd McMillen  
Chairman, Board of Engineers, Interoceanic Inc.  
(Signature of Registrant)

Subscribed and sworn to before me this 31st day of July, 1958.

My commission expires 6/20/59 Marie McMillen  
(Notary Public)

(SEAL)

**CERTIFICATE OF REGISTRATION**

STATE OF OREGON }  
County of Marion } ss.

This is to certify that the foregoing Registration Statement was received in the office of the State Engineer on the 4th day of August, 1958, at 2.00 o'clock A. M. and has been duly recorded in said office in Book No. 15 of Registration Statements on page GR-3766.

Witness my hand this 20th day of October, 1959.

Laura A. Stanley  
(State Engineer)

By \_\_\_\_\_ (Deputy)

# 20.00