

Registration Statement

OF CLAIMANT OF RIGHT TO APPROPRIATE GROUND WATER

TO THE STATE ENGINEER OF OREGON:

I, Anna Neilson Toland
of Rt. 1 Bay City County of Tillamook
(Mailing address)
State of OREGON, do hereby make application for a certificate of registration as evidence of a right to appropriate ground water.

- Source from which water is withdrawn is Pump well
(Flowing well, pump well, infiltration trench, or tunnel)
- Location is: 3 miles North of Tillamook
(Approximate distance and direction from nearest city or town)

and is more particularly described as follows:

(a) 850' South + 530' West of N.W. Corner of NE 1/4 SE 1/4
(Give distance and bearing to corner of section or other legal subdivision)
being within NW 1/4 SE 1/4 of Sec. 12, Twp. 15, Rge. 10 W
(Smallest legal subdivision) (E. or S.) (E. or W.)
or (b) within limits of recorded platted property, town or city:
in Lot _____, Block _____ of _____
(Name of plat or addition)

County of _____
(If within city or town, give name)

3. Construction Work was begun on March 10, 1952; was completed on March 20, 1952
(Date) (Date)
and the ground water claimed was first used for the purposes set out below on July 1, 1952
(Date)
since which time the water has been used intermittently (may-Oct. each yr.)
(Continuously or intermittently)
from 1952 to 1957
(Date) (Date)

4. Quantity of water claimed and used is 84 gallons per minute; 3 acre feet per year.

5. Purpose or Purposes for which water is used irrigation
(Domestic, irrigation, municipal, manufacturing, industrial, etc.)

6. Description of Well: Depth 65 feet. Type Drilled
(Dug or drilled)
diameter 8 inches. Elevation of ground at well site 10 feet, mean sea level.
(As near as known)
Depth to water table 7 1/2 feet.

7. Capacity of Well: 84 g.p.m. with 1/2 feet drawdown.
300 g.p.m. with 1 feet drawdown.

Date of test 25 June, 1952

If Flowing Well: Measured discharge _____ g.p.m. on _____
(Date)

Shut-in pressure at ground surface _____ lbs. per sq. in. on _____
(Date)

Water is controlled by _____
(Cap, valve, etc.)

If log of well is not available, give name and address of driller. Paul Ross, Aloha,
OREGON

11. **Infiltration Trench:** Covered or open
 Dimensions: Length ft. Minimum depth ft. Maximum depth ft.
 Bottom width ft. Discharge g.p.m. Date of test

12. **Tunnel:** Type of lining
 Dimensions:
(Length, course, and cross sectional size)
 Position of water bearing stratum with reference to portal of tunnel

Log of tunnel: (Preceding table for log of well may be used, if desired. Give footage from portal and character of materials, as pertinent.)


13. **Pumping Equipment:**
 (a) Pump Wyss-Correll - 1 1/2" outlet - 2" intake Capacity 300 g.p.m.
(Make, type and size)
 (b) Motor 5 H.P. General Electric - High speed
(Type and horsepower)

14. Location of area irrigated or to be irrigated, or place of use if for purposes other than irrigation.

Township North or South	Range E. or W. of Willamette Meridian	Section	Forty-acre Tract	Number Acres To Be Irrigated	Date of Reclamation
15	10W	12	NW 1/4 SE 1/4	24.4	July 1, 1952
15	10W	12	NE 1/4 SE 1/4	5.4	July 1, 1952
15	10W	12	SW 1/4 SE 1/4	1.4	July 1, 1952
15	10W	12	NE 1/4 SW 1/4	4.8	July 1, 1952
			Total	36.0	

15. If the ground water supply is supplemental to an existing water supply, identification of any application for a permit, permit, certificate or adjudicated right to appropriate water made or held by the registrant.

Township 15 Range 10W, W.M.
North

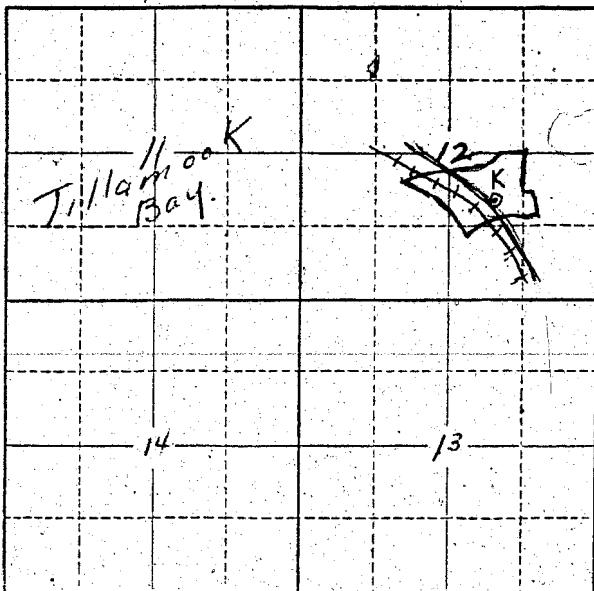

Locate well and acreage of irrigated land on plat.
Scale: 2" = 1 Mile

STATE OF OREGON

County of Tillamook } ss.

I, Anna Nelson Toland being first duly sworn, do hereby certify that I have read the foregoing Registration Statement and that all of the items therein contained are true to the best of my knowledge and belief,

Anna Nelson Toland
(Signature of Registrant)

Subscribed and sworn to before me this 2 day of August, 1958

My commission expires 4-6-59 H. C. Cline
(Notary Public)

(SEAL)

CERTIFICATE OF REGISTRATION

STATE OF OREGON } ss.
County of Marion

This is to certify that the foregoing Registration Statement was received in the office of the State Engineer on the 4 day of August, 1958, at 8:00 o'clock A. M. and has been duly recorded in said office in Book No. 15 of Registration Statements on page GR 3555.

Witness my hand this 15th day of September, 1959

\$15.90

Lewis A. Stanley
(State Engineer)

By _____ (Deputy)

GR 3555