RECEIVED
MAR 11 1957
STATE ENGINEER
SALEM, OREGON

REGISTRATION NO. GR-392
CERTIFICATE NO. GR 378

Registration Statement

OF CLAIMANT OF RIGHT TO APPROPRIATE GROUND WATER

(Under Chapter 708, Oregon Laws 1955.)

TO THE STATE ENGINEER OF OREGON:

I, Harvey and Gladys Knifong and Roy Hayden,

of Milton-Freewater, Ore, Rt 3, Box 257. County of Umatilla

State of Oregon, do hereby make application for a certificate of registration as evidence of a right to appropriate ground water.

1. Source from which water is withdrawn is Well (Flowing well, pump well, infiltration trench, or tunnel)

2. Location is: 1,3/4 miles (Approximate distance and direction from nearest city or town);

and is more particularly described as follows:

(a) 317.05 ft. S. from a point 73 ft. East of the NW cor. of SE/SE 1/4 (Give distance and bearing to corner of section or other legal subdivision)

being within SE 1/4 of the SW 1/4 (Smallest legal subdivision) of Sec. 25, Twp. 6 N. (N. or S.), Rge. 35 E. (E. or W.)

or (b) within limits of recorded platted property, town or city:

in Lot ....., Block ....., of ..... (Name of plat or addition)

..... (If within city or town, give name) County of Umatilla

3. Construction Work was begun on before July 1915 (Date); was completed on July 1915 (Date)

and the ground water claimed was first used for the purposes set out below on July 1915 (Date),

since which time the water has been used continuously (Continuously or intermittently)

from 1915 (Date) to Mar 1 1957. (Date)

4. Quantity of water claimed and used is 75 gallons per minute; 193,800,000 gal. per Yr. acre feet per year.

5. Purpose or Purposes for which water is used Irrigation and Domestic Use

(Domestic, irrigation, municipal, manufacturing, industrial, etc.)

6. Description of Well: Depth 93 feet. Type Dug 46 ft., drilled 47 ft. (Dug or drilled)
Dug part 6'x8', casing 8"
diameter ..... inches. Elevation of ground at well site about 800 (As near as known) feet, mean sea level.

Depth to water table ..... feet. varies from about 18' to 46'
former pump was a 5" centrifugal and 3 H.P.

7. Capacity of Well: ..... g.p.m. with ..... feet drawdown.

..... g.p.m. with ..... feet drawdown.

Date of test not tested

If Flowing Well: Measured discharge ..... g.p.m. on ..... (Date)

Shut-in pressure at ground surface ..... lbs. per sq. in. on ..... (Date)

Water is controlled by ..... (Cap, valve, etc.)

8. **Casing:** (Give diameter, commercial specifications and depth below ground surface of each casing size.)

..... inch diameter ..... from ..... to ..... feet

..... inch diameter ..... from ..... to ..... feet

..... inch diameter ..... from ..... to ..... feet

..... inch diameter ..... from ..... to ..... feet

Describe and show depth of shoe, plug, adapter, liner or other details: .....

.....

.....

9. **Perforated Casings or Screens:**

..... from ..... to .....
(Number per foot and size of perforations, or describe screen)

..... from ..... to .....

..... from ..... to .....

..... from ..... to .....

10. **Log of Well:** (Describe each stratum or formation clearly, indicate if water bearing, and give thickness and depth as indicated.) None available

MATERIAL	Thickness (Feet)	Depth to Bottom (Feet)

GR 378 A

If log of well is not available, give name and address of driller. .....

Well was drilled additionally Feb. 1943 by Overturf & Cornelison

11. **Infiltration Trench:** Covered or open .....

Dimensions: Length ..... ft. Minimum depth ..... ft. Maximum depth ..... ft.

Bottom width ..... ft. Discharge ..... g.p.m. Date of test .....

12. **Tunnel:** Type of lining .....

Dimensions: .....
(Length, course, and cross sectional size)

Position of water bearing stratum with reference to portal of tunnel .....

Log of tunnel: (Preceding table for log of well may be used, if desired. Give footage from portal and character of materials, as pertinent.)

13. **Pumping Equipment:**

(a) Pump 3 H.P. Cook Turbine (Make, type and size) Capacity 75 g.p.m.

(b) Motor 3 phase 3 H.P. motor (Type and horsepower)

14. Location of area irrigated or to be irrigated, or place of use if for purposes other than irrigation.

Township North or South	Range E. or W. of Willamette Meridian	Section	Forty-acre Tract	Number Acres To Be Irrigated	Date of Reclamation
6 N.	35 E.W.M.	35	SE 1/4 of SW 1/4	8.25	1915

15. If the ground water supply is supplemental to an existing water supply, identification of any application for a permit, permit, certificate or adjudicated right to appropriate water made or held by the registrant.

Old - permit - was from Tumalum River - not available now was supplemental to well.

GR 378 B

Township 6 N Range 35 E, W.M.

North

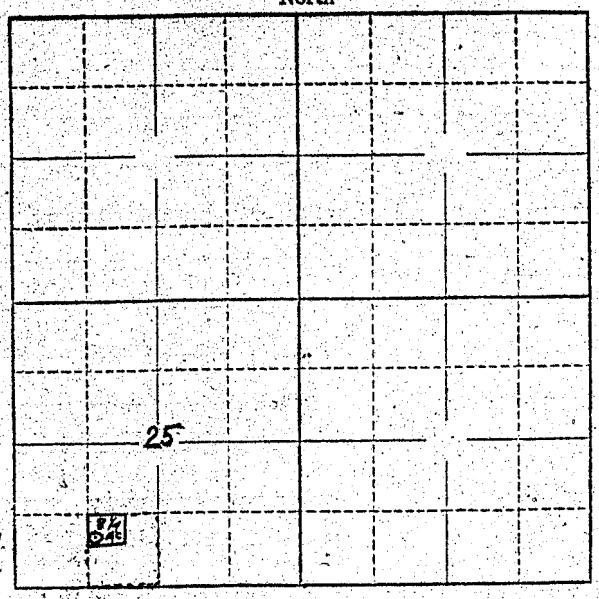

at a point 317.03 south from a pt. pt. 76 ft - East from N W Cor of SE 1/4 of SW 1/4 of Sec. 25 Tp 6 N. E.W.M.

Locate well and acreage of irrigated land on plat.

Scale: 2" = 1 Mile

Well

STATE OF OREGON
County of Umatilla } ss.

I, Gladys Kinsey, being first duly sworn, do hereby certify that I have read the foregoing Registration Statement and that all of the items therein contained are true to the best of my knowledge and belief.

Gladys Kinsey
(Signature of Registrant)

Subscribed and sworn to before me this 8 day of March, 1957

My commission expires March 27, 1959 D. H. De Vaughn
(Notary Public)

(SEAL)

CERTIFICATE OF REGISTRATION

STATE OF OREGON
County of Marion } ss.

This is to certify that the foregoing Registration Statement was received in the office of the State Engineer on the 11th day of March, 1957, at 8:00 o'clock A. M. and has been duly recorded in said office in Book No. 3 of Registration Statements on page GR-378 C.

~~Construction shall be completed by X-X-X-X-X-X-X-X-X-X-X-X-X-X and the water completely applied to the beneficial use by X-X-X-X-X-X-X-X-X-X, 19 -X-X~~

Witness my hand this 30th day of April, 1957

Lewis A. Stanley
(State Engineer)

By
(Deputy)

GR 378 C