

Registration Statement

OF CLAIMANT OF RIGHT TO APPROPRIATE GROUND WATER

TO THE STATE ENGINEER OF OREGON:

I, Slyde M. Johnson
of Route 5 Box 772 Salem County of Marion
State of Oregon, do hereby make application for a certificate of registration as evidence of a right to appropriate ground water.

- 1. Source from which water is withdrawn is Pump well
(Flowing well, pump well, infiltration trench, or tunnel).
- 2. Location is: 4 miles E of 4 corners on State Street;
(Approximate distance and direction from nearest city or town)

and is more particularly described as follows:

(a) 2071' S. 0°20'W and 198' E from NW Cor John L. Eoff Dr.
(Give distance and bearing to corner of section or other legal subdivision)
being within NW 1/4 of SW 1/4 of Sec. 26, Twp. 7 S, Rge. 2 W
(Smallest legal subdivision) (N. or S.) (E. or W.)

or (b) within limits of recorded platted property, town or city:
in Lot _____, Block _____ of _____
(Name of plat or addition)
County of _____
(If within city or town, give name)

3. Construction Work was begun on Nov 1948; was completed on Nov 1948
(Date) (Date)
and the ground water claimed was first used for the purposes set out below on April 1954
(Date)
since which time the water has been used Each Summer
(Continuously or intermittently)
from 1954 to DATE
(Date) (Date)

4. Quantity of water claimed and used is 96 gallons per minute; _____ acre feet per year.

5. Purpose or Purposes for which water is used ~~Domestic~~ + IRRIGATION
(Domestic, irrigation, municipal, manufacturing, industrial, etc.)

6. Description of Well: Depth 71 feet. Type Dribbled
(Dug or drilled)
diameter 6 inches. Elevation of ground at well site _____ feet, mean sea level.
(As near as known)
Depth to water table _____ feet.

7. Capacity of Well: 1500 g.p.m. with _____ feet drawdown.
_____ g.p.m. with _____ feet drawdown.

Date of test 1948

If Flowing Well: Measured discharge _____ g.p.m. on _____
(Date)

Shut-in pressure at ground surface _____ lbs. per sq. in. on _____
(Date)

Water is controlled by _____
(Cap, valve, etc.)


8. Casing: (Give diameter, commercial specifications and depth below ground surface of each casing size.)

6 inch diameter from to feet
 inch diameter from to feet
 inch diameter from to feet
 inch diameter from to feet

Describe and show depth of shoe, plug, adapter, liner or other details:

9. Perforated Casings or Screens:

(Number per foot and size of perforations, or describe screen) from to
 from to
 from to
 from to

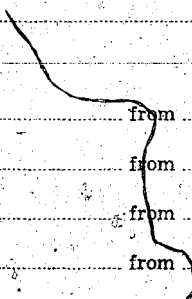

10. Log of Well: (Describe each stratum or formation clearly, indicate if water bearing, and give thickness and depth as indicated.)

MATERIAL	Thickness (Feet)	Depth to Bottom (Feet)

If log of well is not available, give name and address of driller.

11. Infiltration Trench: Covered or open

Dimensions: Length ft. Minimum depth ft. Maximum depth ft.

Bottom width ft. Discharge g.p.m. Date of test

12. Tunnel: Type of lining

Dimensions:
(Length, course, and cross sectional size)

Position of water bearing stratum with reference to portal of tunnel

Log of tunnel: (Preceding table for log of well may be used, if desired. Give footage from portal and character of materials, as pertinent.)

13. Pumping Equipment:

(a) Pump *Meyers Jet 1 1/2 1HP* Capacity *1200* g.p.m.
(Make, type and size)


(b) Motor *1 H.P. Electric*
(Type and horsepower)

14. Location of area irrigated or to be irrigated, or place of use if for purposes other than irrigation.

Township North or South	Range E. or W. of Willamette Meridian	Section	Forty-acre Tract	Number Acres To Be Irrigated	Date of Reclamation
T7S	R2W	26	Fr NE 1/4 SW 1/4	5.66	1954
T7S	R2W	26	Fr SW 1/4 of SW 1/4	5.66	1954
"	"	"	NE 1/4 of SW 1/4	5.66	"

15. If the ground water supply is supplemental to an existing water supply, identification of any application for a permit, permit, certificate or adjudicated right to appropriate water made or held by the registrant.

Township 7S Range 2W, W.M.
North

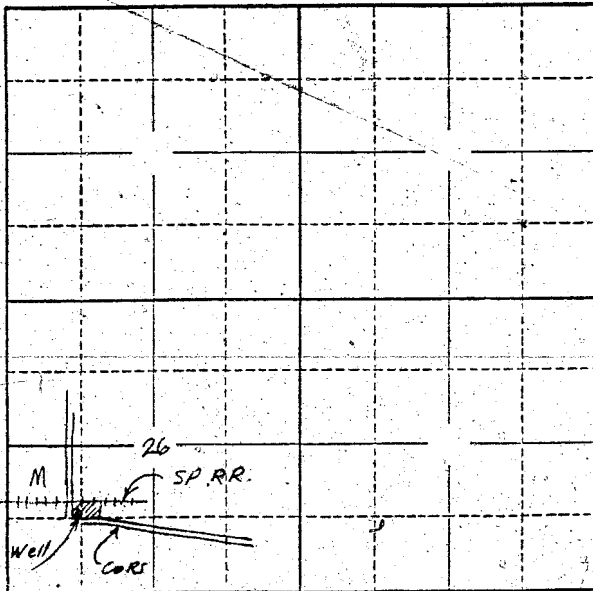

Locate well and acreage of irrigated land on plat.

Scale: 2" = 1 Mile

STATE OF OREGON

County of Marion } ss.

I, Clyde M Johnson, being first duly sworn, do hereby certify that I have read the foregoing Registration Statement and that all of the items therein contained are true to the best of my knowledge and belief.

Clyde M Johnson
(Signature of Registrant)

Subscribed and sworn to before me this 4th day of August, 1958.

My commission expires 12th June 1961 Wm. S. Bartholomew
(Notary Public)

(SEAL)

CERTIFICATE OF REGISTRATION

STATE OF OREGON } ss.
County of Marion

This is to certify that the foregoing Registration Statement was received in the office of the State Engineer on the 4th day of August, 1958, at 10:00 o'clock A. M. and has been duly recorded in said office in Book No. 15 of Registration Statements on page 6A-3561

Witness my hand this 15th day of September, 1959.

Lewis A. Stanley
(State Engineer)

By _____ (Deputy)

\$15.00

GR 3561