REGISTRATION NO. GR-3927

CERTIFICATE NO. GR-3562

Registration Statement

OF CLAIMANT OF RIGHT TO APPROPRIATE GROUND WATER

(Under Chapter 708, Oregon Laws 1955.)

TO THE STATE ENGINEER OF OREGON:

I, Arnold Eberlein,

of Route 3, Junction City County of Benton

State of Oregon, do hereby make application for a certificate of registration as evidence of a right to appropriate ground water.

1. **Source** from which water is withdrawn is pump well
(Flowing well, pump well, infiltration trench, or tunnel).

2. **Location is:** 3 miles NE of Monroe
(Approximate distance and direction from nearest city or town);

and is more particularly described as follows: 281' W, S 0° 09' E 836' to SW corner Samuel H. Oliver

(a) DLC # 47, said corner located in SW NE, Sec 22, T 14S, R 5W, W.M., said well
(Give distance and bearing to corner of section or other legal subdivision)

being within NW NE of Sec. 22, Twp. 14S (N. or S.), Rge. 5W (E. or W.)
(Smallest legal subdivision)

or (b) within limits of recorded platted property, town or city:

in Lot ....., Block ..... of .....
(Name of plat or addition)

..... County of .....
(If within city or town, give name)

3. **Construction Work** was begun on 1952 (Date); was completed on 1952 (Date)

and the ground water claimed was first used for the purposes set out below on 1952 (Date),

since which time the water has been used intermittently
(Continuously or intermittently)

from 1952 (Date) to 1957 (Date)

4. **Quantity** of water claimed and used is 150 when pumping gallons per minute; 45 acre feet per year.

5. **Purpose or Purposes** for which water is used irrigation

.....
(Domestic, irrigation, municipal, manufacturing, industrial, etc.)

6. **Description of Well:** Depth 21 feet. Type driven
(Dug or drilled)

diameter 4 inches. Elevation of ground at well site 276 (As near as known) feet, mean sea level.

Depth to water table 12 feet.

7. **Capacity of Well:** 150 sucked directly from casing g.p.m. with ..... feet drawdown.

..... g.p.m. with ..... feet drawdown.

Date of test 1952

If Flowing Well: Measured discharge ..... g.p.m. on .....
(Date)

Shut-in pressure at ground surface ..... lbs. per sq. in. on .....
(Date)

Water is controlled by .....
(Cap, valve, etc.)

8. **Casing:** (Give diameter, commercial specifications and depth below ground surface of each casing size.)

4 inch diameter steel from surface to 21 feet

inch diameter from to feet

inch diameter from to feet

inch diameter from to feet

Describe and show depth of shoe, plug, adapter, liner or other details:

9. **Perforated Casings or Screens:**

slotted, size and number unknown from 18' to 21'
(Number per foot and size of perforations, or describe screen)

from to

from to

from to

10. **Log of Well:** (Describe each stratum or formation clearly, indicate if water bearing, and give thickness and depth as indicated.)

MATERIAL	Thickness (Feet)	Depth to Bottom (Feet)
unknown		

GR-3562

If log of well is not available, give name and address of driller. unknown

11. **Infiltration Trench:** Covered or open .....

Dimensions: Length ..... ft. Minimum depth ..... ft. Maximum depth ..... ft.

Bottom width ..... ft. Discharge ..... g.p.m. Date of test .....

12. **Tunnel:** Type of lining .....

Dimensions: .....
(Length, course, and cross sectional size)

Position of water bearing stratum with reference to portal of tunnel .....

Log of tunnel: (Preceding table for log of well may be used, if desired. Give footage from portal and character of materials, as pertinent.)

13. **Pumping Equipment:**

(a) Pump 2 x 1½ centrifugal (Make, type and size) Capacity 200 g.p.m.

(b) Motor stationary gas motor, 36 hp (Type and horsepower)

14. Location of area irrigated or to be irrigated, or place of use if for purposes other than irrigation.

Township North or South	Range E. or W. of Willamette Meridian	Section	Forty-acre Tract	Number Acres To Be Irrigated	Date of Reclamation
14	5W	22	NE¼ NE¼	6.0	1952
14	5W	22	NW¼ NE¼	6.5	1952
14	5	15	SE¼ SE¼	0.5	1952
			Total	13.0	

15. If the ground water supply is supplemental to an existing water supply, identification of any application for a permit, permit, certificate or adjudicated right to appropriate water made or held by the registrant.

GR-3562

Township 14S Range 5W, W.M.

North

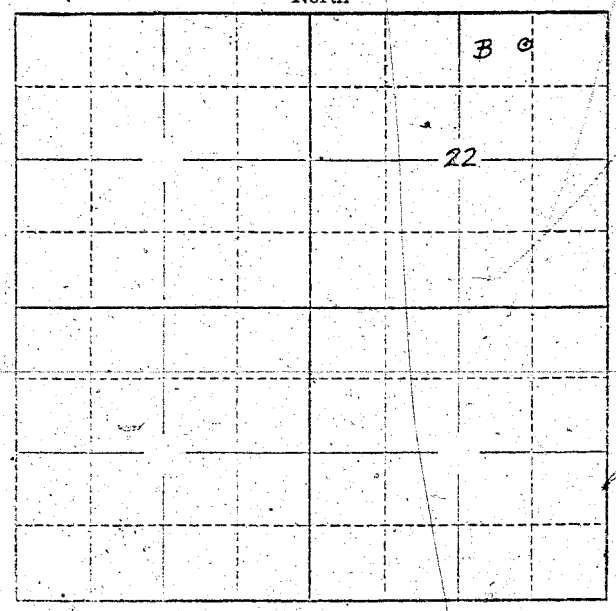

Locate well and acreage of irrigated land on plat.

Scale: 2" = 1 Mile

STATE OF OREGON
County of Benton } ss.

I, Arnold Eberlein, being first duly sworn, do hereby certify that I have read the foregoing Registration Statement and that all of the items therein contained are true to the best of my knowledge and belief.

Arnold Eberlein
(Signature of Registrant)

Subscribed and sworn to before me this 30th day of July, 1958.

My commission expires May 22, 1961

Leora B. Turner
(Notary Public)

(SEAL)

CERTIFICATE OF REGISTRATION

STATE OF OREGON
County of Marion } ss.

This is to certify that the foregoing Registration Statement was received in the office of the State Engineer on the 12th day of ~~July~~ August, 1958, at 2:00 o'clock A M. and has been duly recorded in said office in Book No. 15 of Registration Statements on page GR-3562

~~xx Construction shall be completed by xxxxxxxxxxxxxxxxxxxxxxxxxxxxxxxxxxxx and the water completely applied to xxxxxxxxxxxxxxxxxxxx