

# Registration Statement

## OF CLAIMANT OF RIGHT TO APPROPRIATE GROUND WATER

TO THE STATE ENGINEER OF OREGON:

I, Chas. L. Mann  
 of Rt. 1 Box 217 E Aumsville County of Marion  
(Mailing address)  
 State of Ore., do hereby make application for a certificate of registration as evidence of a right to appropriate ground water.

- Source from which water is withdrawn is Pond  
(Flowing well, pump well, infiltration trench, or tunnel)
- Location is: 2 mi. S.W. Aumsville  
(Approximate distance and direction from nearest city or town)

and is more particularly described as follows:

(a) 300 feet west & 1500 feet north from SE corner Section 34  
(Give distance and bearing to corner of section or other legal subdivision)  
 being within NE 1/4 of SE 1/4 of Sec. 34, Twp. 8S, Rge. 2W  
(Smallest legal subdivision) (N. or S.) (E. or W.)  
 or (b) within limits of recorded platted property, town or city:  
 in Lot \_\_\_\_\_, Block \_\_\_\_\_ of \_\_\_\_\_  
(Name of plat or addition)

County of \_\_\_\_\_  
(If within city or town, give name)

3. Construction Work was begun on 1953; was completed on 1953  
(Date) (Date)  
 and the ground water claimed was first used for the purposes set out below on 1953  
(Date)  
 since which time the water has been used \_\_\_\_\_  
(Continuously or Intermittently)  
 from 1953 to Oct 57  
(Date) (Date)

4. Quantity of water claimed and used is 135 gallons per minute; \_\_\_\_\_ acre feet per year.

5. Purpose or Purposes for which water is used Irrigation

6. Description of Well: <sup>Sump</sup> ~~Drilled~~ ~~for irrigation, manufacturing, or other purposes~~  
 Depth 20 feet. Type dry dug  
(Dug or drilled)  
 diameter See 11 inches. Elevation of ground at well site \_\_\_\_\_ feet, mean sea level.  
(As near as known)  
 Depth to water table 3 feet.

7. Capacity of Well: \_\_\_\_\_ g.p.m. with \_\_\_\_\_ feet drawdown.  
 \_\_\_\_\_ g.p.m. with \_\_\_\_\_ feet drawdown.

Date of test \_\_\_\_\_

If Flowing Well: Measured discharge \_\_\_\_\_ g.p.m. on \_\_\_\_\_  
(Date)

Shut-in pressure at ground surface \_\_\_\_\_ lbs. per sq. in. on \_\_\_\_\_  
(Date)


Water is controlled by \_\_\_\_\_  
(Cap, valve, etc.)





Township 85 Range 2W W.M.

North

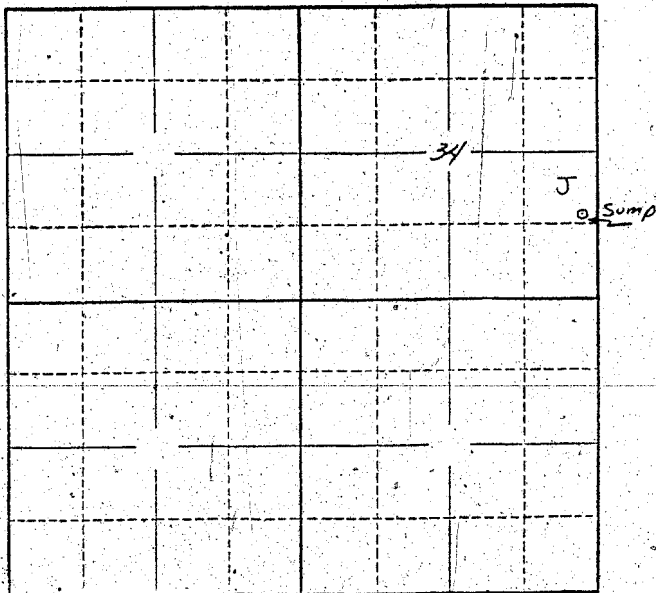

Locate well and acreage of irrigated land on plat.

Scale: 2" = 1 Mile

STATE OF OREGON

County of Marian } ss.

I, L. L. Mann, being first duly sworn, do hereby certify that I have read the foregoing Registration Statement and that all of the items therein contained are true to the best of my knowledge and belief.

L. L. Mann  
(Signature of Registrant)

Subscribed and sworn to before me this 4th day of August, 1958

My commission expires 12th June 1961 Wm. S. Bartholomew  
(Notary Public)

(SEAL)

**CERTIFICATE OF REGISTRATION**

STATE OF OREGON

County of Marian } ss.

This is to certify that the foregoing Registration Statement was received in the office of the State Engineer on the 4th day of August, 1958, at 11:20 o'clock A. M. and has been duly recorded in said office in Book No. 15 of Registration Statements on page 62 3572.

Witness my hand this 15th day of September, 1959

Henry A. Stanley  
(State Engineer)

\$15.00

By \_\_\_\_\_ (Deputy)

GR 3572