

RECEIVED

STATE ENGINEER
SALEM, OREGON

REGISTRATION NO. GR-394

CERTIFICATE NO. GR-3969

Registration Statement

OF CLAIMANT OF RIGHT TO APPROPRIATE GROUND WATER

(Under Chapter 708, Oregon Laws 1955.)

TO THE STATE ENGINEER OF OREGON:

I, Paul Rigor

of Route 3 Box 585, Corvallis County of Benton

State of Oregon, do hereby make application for a certificate of registration as evidence of a right to appropriate ground water.

1. Source from which water is withdrawn is Pump Well
(Flowing well, pump well, infiltration trench, or tunnel)

2. Location is: 6 miles North East of Monroe
(Approximate distance and direction from nearest city or town)

and is more particularly described as follows: starting at S.W. corner of SW 1/4 of

(a) SE 1/4 of Sec. 12 Twp. 14 South Rge. 5 West 90° 20' N then 54° E
(Give distance and bearing to corner of section or other legal subdivision)

being within SW 1/4 of the SE 1/4 of Sec. 12, Twp. 14 South, Rge. 5 West
(Smallest legal subdivision) (N. or S.) (E. or W.)

or (b) within limits of recorded platted property, town or city: _____

in Lot _____, Block _____ of _____
(Name of plat or addition)

County of Benton
(If within city or town, give name)

3. Construction Work was begun on March 25, 1955; was completed on April 2, 1955
(Date) (Date)

and the ground water claimed was first used for the purposes set out below on July 1955
(Date)

since which time the water has been used intermittently from July to October
(Continuously or intermittently)

from July to October
(Date) (Date)

4. Quantity of water claimed and used is 300 gallons per minute; 45 acre feet per year.

5. Purpose or Purposes for which water is used Irrigation

(Domestic, irrigation, municipal, manufacturing, industrial, etc.)

6. Description of Well: Depth 25 feet. Type drilled
(Dug or drilled)

diameter 5 inches. Elevation of ground at well site _____ feet, mean sea level.
(As near as known)

Depth to water table 8 feet.

7. Capacity of Well: _____ g.p.m. with _____ feet drawdown.

_____ g.p.m. with _____ feet drawdown.

Date of test No Test

If Flowing Well: Measured discharge _____ g.p.m. on _____
(Date)

Shut-in pressure at ground surface _____ lbs. per sq. in. on _____
(Date)

Water is controlled by _____
(Cap, valve, etc.)

8. Casing: (Give diameter, commercial specifications and depth below ground surface of each casing size.)

5 inch diameter from surface to 20 feet
..... inch diameter from to feet
..... inch diameter from to feet
..... inch diameter from to feet

Describe and show depth of shoe, plug, adapter, liner or other details:

9. Perforated Casings or Screens:

..... from to
(Number per foot and size of perforations, or describe screen)
..... from to
..... from to
..... from to

10. Log of Well: (Describe each stratum or formation clearly, indicate if water bearing, and give thickness and depth as indicated.)

MATERIAL	Thickness (Feet)	Depth to Bottom (Feet)
<u>None</u>		

If log of well is not available, give name and address of driller. *O. B. Nye*

Route 1 Monroe

11. Infiltration Trench: Covered or open
Dimensions: Length ft. Minimum depth ft. Maximum depth ft.
Bottom width ft. Discharge g.p.m. Date of test

12. Tunnel: Type of lining
Dimensions:
(Length, course, and cross sectional size)
Position of water bearing stratum with reference to portal of tunnel

Log of tunnel: (Preceding table for log of well may be used, if desired. Give footage from portal and character of materials, as pertinent.)


13. Pumping Equipment:
(a) Pump *Gardner Denver 3" outlet* Capacity g.p.m.
(Make, type and size)
(b) Motor *Case 35 H.P.*
(Type and horsepower)

14. Location of area irrigated or to be irrigated, or place of use if for purposes other than irrigation.

Township North or South	Range E. or W. of Willamette Meridian	Section	Forty-acre Tract	Number Acres To Be Irrigated	Date of Reclamation
<i>14 South</i>	<i>5 West</i>	<i>12</i>	<i>SW 1/4 of SE 1/4</i>	<i>30</i>	<i>July, 1955</i>

15. If the ground water supply is supplemental to an existing water supply, identification of any application for a permit, permit, certificate or adjudicated right to appropriate water made or held by the registrant.

Township 14 S Range 5 W W.M.
North

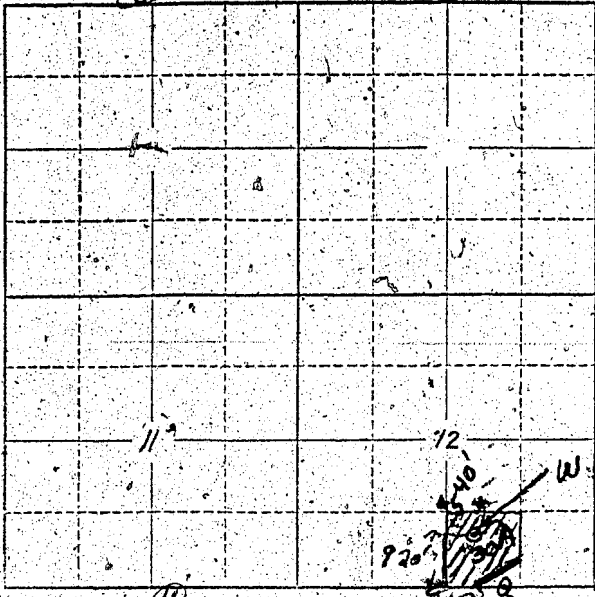

Locate well and acreage of irrigated land on plat.
Scale: 2" = 1 Mile 1/2 section corner

STATE OF OREGON

County of Denton ss.

I, Paul Riggs, being first duly sworn, do hereby certify that I have read the foregoing Registration Statement and that all of the items therein contained are true to the best of my knowledge and belief.

Paul Riggs
(Signature of Registrant)

Subscribed and sworn to before me this 7th day of March 1957

My commission expires PUBLIC FOR OREGON
My Commission Expires March 29, 1960

Ernest J. Smith
(Notary Public)

(SEAL)

CERTIFICATE OF REGISTRATION

STATE OF OREGON

County of Marion ss.

This is to certify that the foregoing Registration Statement was received in the office of the State Engineer on the 12th day of March, 1957, at 8:00 o'clock A.M. and has been duly recorded in said office in Book No. 16 of Registration Statements on page GR-3969

~~Construction shall be completed by xxxxxxxxxxxxxxxxxx and the water completely applied to xxxxxxxxxxxxxxxxxx~~

Witness my hand this 15th day of February, 1960

James A. Stanley
(State Engineer)

\$15.00

By _____ (Deputy)

GR-3969