

# Registration Statement

## OF CLAIMANT OF RIGHT TO APPROPRIATE GROUND WATER

### TO THE STATE ENGINEER OF OREGON:

I, Northrup Bates, or W. K. Bates dba as Bates Brothers,  
of Route 1 Box 3 Aumsville County of Marion  
(Mailing address)

State of Oregon, do hereby make application for a certificate of registration as evidence of a right to appropriate ground water.

1. Source from which water is withdrawn is sump  
(Flowing well, pump well, infiltration trench, or tunnel)

2. Location is: one to two miles South of Aumsville  
(Approximate distance and direction from nearest city or town)

and is more particularly described as follows:

(a) 46.50 chains North and 1.5 chains East from the Southeast corner of the John McHaley LLC  
(Give distance and bearing to corner of section or other legal subdivision)  
being within SW 1/4 of the NW 1/4 of Sec. 31, Twp. 8 S., Rge. 1 W.  
(Smallest legal subdivision) (N. or S.) (E. or W.)

or (b) within limits of recorded platted property, town or city:

in Lot \_\_\_\_\_, Block \_\_\_\_\_ of \_\_\_\_\_  
(Name of plat or addition)  
County of Marion  
(If within city or town, give name)

3. Construction Work was begun on Prior to 1955; was completed on Prior to 1955  
(Date) (Date)

and the ground water claimed was first used for the purposes set out below on April 1955  
(Date)

since which time the water has been used continuously  
(Continuously or intermittently)

from 1955 to the present  
(Date) (Date)

4. Quantity of water claimed and used is 80 gallons per minute; \_\_\_\_\_ acre feet per year.

5. Purpose or Purposes for which water is used irrigation

(Domestic, irrigation, municipal, manufacturing, industrial, etc.)

6. Description of Well: Depth \_\_\_\_\_ feet. Type sump 16 feet X 54 feet, 9 feet deep  
(Dug or drilled)

diameter \_\_\_\_\_ inches. Elevation of ground at well site \_\_\_\_\_ feet, mean sea level.  
(As near as known)

Depth to water table 21/2 feet feet.

7. Capacity of Well: \_\_\_\_\_ g.p.m. with \_\_\_\_\_ feet drawdown.

\_\_\_\_\_ g.p.m. with \_\_\_\_\_ feet drawdown.

Date of test \_\_\_\_\_

If Flowing Well: Measured discharge \_\_\_\_\_ g.p.m. on \_\_\_\_\_  
(Date)


Shut-in pressure at ground surface \_\_\_\_\_ lbs. per sq. in. on \_\_\_\_\_  
(Date)

Water is controlled by \_\_\_\_\_  
(Cap, valve, etc.)





Township 8S Range 1W W.M.  
North

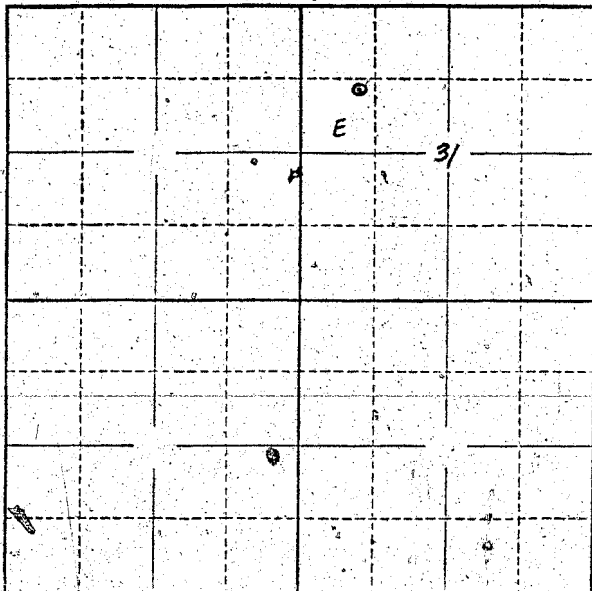

Locate well and acreage of irrigated land on plat.  
Scale: 2" = 1 Mile

STATE OF OREGON

County of Marion } ss.

I, N. K. Bates, Iba Bates Brothers, being first duly sworn, do hereby certify that I have read the foregoing Registration Statement and that all of the items therein contained are true to the best of my knowledge and belief.

[Signature]  
(Signature of Registrant)

Subscribed and sworn to before me this 2 day of August, 1958

My commission expires May 20, 1961  
[Signature]  
(Notary Public)

(SEAL)

**CERTIFICATE OF REGISTRATION**

STATE OF OREGON

County of Marion } ss.

This is to certify that the foregoing Registration Statement was received in the office of the State Engineer on the 4th day of August, 1958, at 11:30 o'clock A. M. and has been duly recorded in said office in Book No. 15 of Registration Statements on page GR-3573

Witness my hand this 15th day of September, 1959

[Signature]  
(State Engineer)

By \_\_\_\_\_  
(Deputy)

GR 3573

\$15.00