

Registration No. GR 3943
Certificate No. GR 3575

Registration Statement

OF CLAIMANT OF RIGHT TO APPROPRIATE GROUND WATER

TO THE STATE ENGINEER OF OREGON:

I, Rebecca Signor
of Rte #1, Box 287, Portland, 10 County of Multnomah
(Mailing address)
State of Oregon do hereby make application for a certificate of registration as evidence of a right to appropriate ground water.

1. Source from which water is withdrawn is Pump well
(Flowing well, pump well, infiltration trench, or tunnel)

2. Location is: 5 1/2 N.W. Portland on Highway 30
(Approximate distance and direction from nearest city or town)

and is more particularly described as follows:

(a) N 76°00' W SE cor Sec 12 200'
(Give distance and bearing to corner of section or other legal subdivision)
being within SE 1/4, SE 1/4 of Sec. 12, Twp. 2N, Rge. 2W
(Smallest legal subdivisions) (N. or S.) (E. or W.)

or (b) within limits of recorded platted property; town or city:

in Lot _____, Block _____ of _____
(Name of plat or addition)
County of _____
(If within city or town, give name)

3. Construction Work was begun on January 1953; was completed on January 1953
(Date) (Date)
and the ground water claimed was first used for the purposes set out below on January 1953
(Date)
since which time the water has been used Continuously 12 mo/yr
(Continuously or Intermittently)
from 1953 to 1958
(Date) (Date)

4. Quantity of water claimed and used is 15 gallons per minute; 9 acre feet per year.

5. Purpose or Purposes for which water is used irrigation (greenhouse)

(Domestic, irrigation, municipal, manufacturing, industrial, etc.)

6. Description of Well: Depth 152 feet. Type drilled
(Dug or drilled)
diameter 6 inches. Elevation of ground at well site 200 feet, mean sea level.
(As near as known)
Depth to water table 80 feet.

7. Capacity of Well: 15 g.p.m. with 8 feet drawdown.
_____ g.p.m. with _____ feet drawdown.

Date of test January 1953

If Flowing Well: Measured discharge _____ g.p.m. on _____
(Date)

Shut-in pressure at ground surface _____ lbs. per sq. in. on _____
(Date)

Water is controlled by _____
(Cap, valve, etc.)

8. Casing: (Give diameter, commercial specifications and depth below ground surface of each casing size.)

6 inch diameter Steel from 0 to 152 feet
inch diameter from to feet
inch diameter from to feet
inch diameter from to feet

Describe and show depth of shoe, plug, adapter, liner or other details:

Shoe - standard - plain end - black

9. Perforated Casings or Screens:

bottom 40' from to
(Number per foot and size of perforations, or describe screen)
from to
from to
from to

10. Log of Well: (Describe each stratum or formation clearly, indicate if water bearing, and give thickness and depth as indicated.)

MATERIAL	Thickness (Feet)	Depth to Bottom (Feet)
clay	6	
firm sandy silt	74	
blue clay	54	
brown sand	3	
gravel (cement)	3	
sand and gravel	10	

If log of well is not available, give name and address of driller

11. **Infiltration Trench:** Covered or open

Dimensions: Length ft. Minimum depth ft. Maximum depth ft.

Bottom width ft. Discharge g.p.m. Date of test

12. **Tunnel:** Type of lining

Dimensions:
(Length, course, and cross sectional size)

Position of water bearing stratum with reference to portal of tunnel

Log of tunnel: (Preceding table for log of well may be used, if desired. Give footage from portal and character of materials, as pertinent.)

13. **Pumping Equipment:**

(a) Pump Pacific Submersible 2" Capacity 15 g.p.m.
(Make, type and size)


(b) Motor Submersible electric
(Type and horsepower)

14. Location of area irrigated or to be irrigated, or place of use if for purposes other than irrigation.

Township North or South	Range E. or W. of Williamsite Meridian	Section	Forty-acre Tract	Number Acres To Be Irrigated	Date of Reclamation
2N	1W	7	SW $\frac{1}{4}$ SW $\frac{1}{4}$	0.75	January 1953
2N	2W	12	SE $\frac{1}{4}$ SE $\frac{1}{4}$	1.75	January 1953
2N	2W	13	NE $\frac{1}{4}$ NE $\frac{1}{4}$	0.3	January 1953
				<u>2.80</u> Ac	

15. If the ground water supply is supplemental to an existing water supply, identification of any application for a permit, permit, certificate or adjudicated right to appropriate water made or held by the registrant.

Township 2N Range 2W, W.M.
North

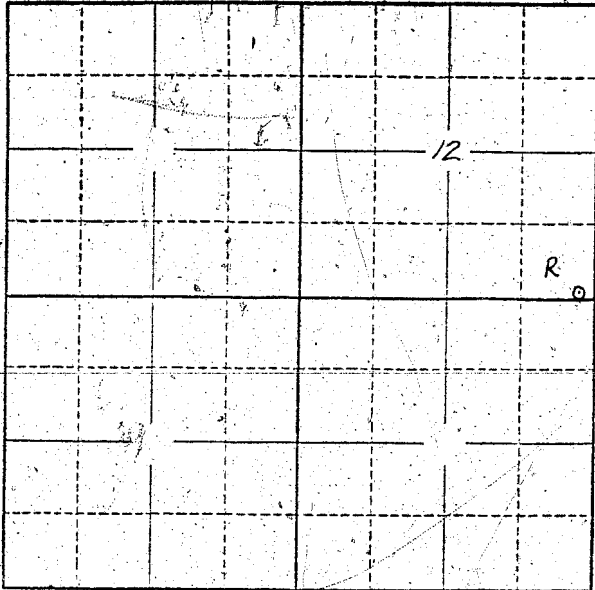

Locate well and acreage of irrigated land on plat.
Scale: 2" = 1 Mile

STATE OF OREGON

County of Washington } ss.

I, Walter J. [unclear], being first duly sworn, do hereby certify that I have read the foregoing Registration Statement and that all of the items therein contained are true to the best of my knowledge and belief.

[Signature]
(Signature of Registrant)

Subscribed and sworn to before me this 14 day of August, 1957

My commission expires NOTARY PUBLIC FOR OREGON

My Commission Expires Feb. 10, 1960

[Signature]
(Notary Public)

(SEAL)

CERTIFICATE OF REGISTRATION

STATE OF OREGON

County of Marion } ss.

This is to certify that the foregoing Registration Statement was received in the office of the State Engineer on the 4th day of August, 1957, at 2:00 o'clock A. M. and has been duly recorded in said office in Book No. 15 of Registration Statements on page GR-3575

Witness my hand this 15th day of September, 1959

\$15.00

Lewis A. Stanley
(State Engineer)

By _____ (Deputy)

GR. 3575