

Registration No. GR. 3946

Certificate No. GR. 3576

Registration Statement

OF CLAIMANT OF RIGHT TO APPROPRIATE GROUND WATER

TO THE STATE ENGINEER OF OREGON:

I, Clyde A. Keever
of Rt. 1, Box 351, Springfield, Ore. County of Lane
(Mailing address)
State of Ore., do hereby make application for a certificate of registration as evidence of a right to appropriate ground water.

1. Source from which water is withdrawn is Pump Well
(Flowing well, pump well, infiltration trench, or tunnel)

2. Location is: 5 miles east of Springfield
(Approximate distance and direction from nearest city or town)

and is more particularly described as follows:

(a) 1350 ft. 285° from SE corner Sec 5
(Give distance and bearing to corner of section or other legal subdivision)
being within SE 1/4 of SE 1/4 of Sec. 5, Twp. 18 S, Rge. 2 W
(Smallest legal subdivision) (N. or S.) (E. or W.)

or (b) within limits of recorded platted property, town or city:

in Lot _____, Block _____ of _____
(Name of plat or addition)

County of _____
(If within city or town, give name)

3. Construction Work was begun on ?; was completed on 1938
(Date) (Date)

and the ground water claimed was first used for the purposes set out below on 1938
(Date)

since which time the water has been used intermittently
(Continuously or intermittently)

from 1938 to present
(Date) (Date)

4. Quantity of water claimed and used is 450 gallons per minute; ? acre feet per year.

5. Purpose or Purposes for which water is used Irrigation
(Domestic, irrigation, municipal, manufacturing, industrial, etc.)

6. Description of Well: Depth 20 feet. Type Drum
(Dug or drilled)

diameter 7 inches. Elevation of ground at well site 480 feet, mean sea level.
(As near as known)

Depth to water table 10 feet.

7. Capacity of Well: not tested g.p.m. with _____ feet drawdown.
_____ g.p.m. with _____ feet drawdown.

Date of test _____

If Flowing Well: Measured discharge _____ g.p.m. on _____
(Date)

Shut-in pressure at ground surface _____ lbs. per sq. in. on _____
(Date)

Water is controlled by _____
(Cap, valve, etc.)

8. Casing: (Give diameter, commercial specifications and depth below ground surface of each casing size.)

4 inch iron pipe, driven to about 20 ft.

..... inch diameter from to feet

..... inch diameter from to feet

..... inch diameter from to feet

..... inch diameter from to feet

Describe and show depth of shoe, plug, adapter, liner or other details:

9. Perforated Casings or Screens:

(Number per foot and size of perforations, or describe screen)

..... from to

..... from to

..... from to

..... from to

10. Log of Well: (Describe each stratum or formation clearly, indicate if water bearing, and give thickness and depth as indicated.)

MATERIAL	Thickness (Feet)	Depth to Bottom (Feet)

If log of well is not available, give name and address of driller.

11. Infiltration Trench: Covered or open

Dimensions: Length _____ ft. Minimum depth _____ ft. Maximum depth _____ ft.

Bottom width _____ ft. Discharge _____ g.p.m. Date of test _____

12. Tunnel: Type of lining

Dimensions: _____
(Length, course, and cross sectional size)

Position of water bearing stratum with reference to portal of tunnel

Log of tunnel: (Preceding table for log of well may be used, if desired. Give footage from portal and character of materials, as pertinent.)

13. Pumping Equipment:

(a) Pump *centrifugal portable* Capacity _____ g.p.m.
(Make, type and size)


(b) Motor _____
(Type and horsepower)

14. Location of area irrigated or to be irrigated, or place of use if for purposes other than irrigation.

Township North or South	Range E. or W. of Willamette Meridian	Section	Forty-acre Tract	Number Acres To Be Irrigated	Date of Reclamation
18 S	R2W	5	SE $\frac{1}{4}$ of SE $\frac{1}{4}$	8 [±]	1938
"	"	8	NE $\frac{1}{4}$ of NE $\frac{1}{4}$	12 [±]	"
				20 [±] total	"

15. If the ground water supply is supplemental to an existing water supply, identification of any application for a permit, permit, certificate or adjudicated right to appropriate water made or held by the registrant.

Township 18 S Range 2 W, W.M.
North

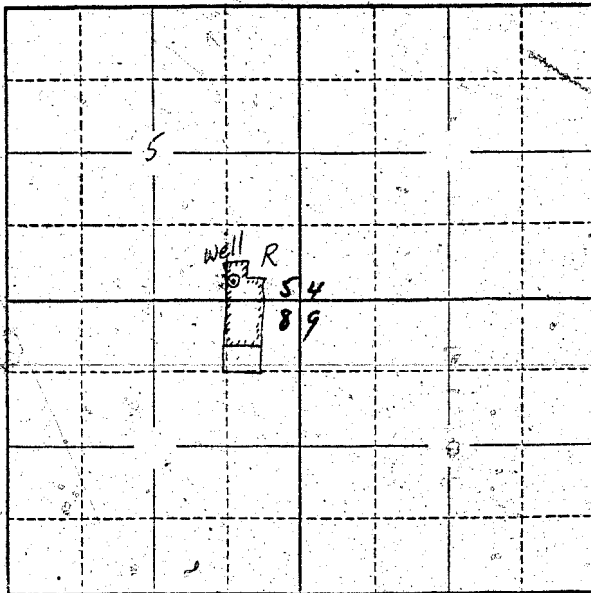

Locate well and acreage of irrigated land on plat.
Scale: 2" = 1 Mile

STATE OF OREGON

County of Lane } ss.

I, Clyde A. Keever being first duly sworn, do hereby certify that I have read the foregoing Registration Statement and that all of the items therein contained are true to the best of my knowledge and belief.

x Clyde A. Keever
(Signature of Registrant)

Subscribed and sworn to before me this 31st day of July, 1958

My commission expires Sept 9, 1960
 Gordon C. Brubaker
(Notary Public)

(SEAL)

CERTIFICATE OF REGISTRATION

STATE OF OREGON

County of Marion } ss.

This is to certify that the foregoing Registration Statement was received in the office of the State Engineer on the 4th day of August, 1958, at 8⁰⁰ o'clock A. M. and has been duly recorded in said office in Book No. 15 of Registration Statements on page GR 3576

Witness my hand this 15th day of September, 1959
Lewis A. Stanley
(State Engineer)

\$15.00

By _____ (Deputy)

GR 3576