

RECEIVED

MAR 13 1957
STATE ENGINEER
SALEM, OREGON

REGISTRATION NO. GR-395
CERTIFICATE NO. GR-2437

Registration Statement

OF CLAIMANT OF RIGHT TO APPROPRIATE GROUND WATER

(Under Chapter 708, Oregon Laws 1955.)

TO THE STATE ENGINEER OF OREGON:

I, Wm. L. Sacre
of Amity County of Thurman

State of Oregon, do hereby make application for a certificate of registration as evidence of a right to appropriate ground water.

1. Source from which water is withdrawn is pump well
(Flowing well, pump well, infiltration trench, or tunnel)

2. Location is: 1/2 mile south of Amity
(Approximate distance and direction from nearest city or town)

and is more particularly described as follows:

(a) South 2075 ft & 1750 ft East of NW Cor of Buffum D.C. No 1295 CL 48 IN T5S, R4W, W.M.
(Give distance and bearing to corner of section or other legal subdivision)

being within SW 1/4 of NW 1/4 of Sec. 27, Twp. 5S, Rge. 4W
(Smallest legal subdivision) (or S.) (or W.)

or (b) within limits of recorded platted property, town or city:

in Lot _____, Block _____ of _____
(Name of plat or addition)

County of _____
(If within city or town, give name)

3. Construction Work was begun on March 53; was completed on March 1953
(Date) (Date)

and the ground water claimed was first used for the purposes set out below on March 1953
(Date)

since which time the water has been used intermittently
(Continuously or intermittently)

from March 1953 to up to now
(Date) (Date)

4. Quantity of water claimed and used is 120 gallons per minute; 25 acre feet per year.

5. Purpose or Purposes for which water is used irrigation

(Domestic, irrigation, municipal, manufacturing, industrial, etc.)

6. Description of Well: Depth 27 feet. Type drilled
(Dug or drilled)

diameter 10 inches. Elevation of ground at well site _____ feet, mean sea level.
(As near as known)

Depth to water table 18 feet.

7. Capacity of Well: 120 g.p.m. with 55 feet drawdown.

_____ g.p.m. with _____ feet drawdown.

Date of test March 1953

If Flowing Well: Measured discharge _____ g.p.m. on _____
(Date)

Shut-in pressure at ground surface _____ lbs. per sq. in. on _____
(Date)

Water is controlled by _____
(Cap, valve, etc.)

If log of well is not available, give name and address of driller:

11. Infiltration Trench: Covered or open

Dimensions: Length ft. Minimum depth ft. Maximum depth ft.

Bottom width ft. Discharge g.p.m. Date of test

12. Tunnel: Type of lining

Dimensions:
(Length, course, and cross sectional size)

Position of water bearing stratum with reference to portal of tunnel

Log of tunnel: (Preceding table for log of well may be used, if desired. Give footage from portal and character of materials, as pertinent.)

13. Pumping Equipment:

(a) Pump *Gilchrist Motor 10 H.P.* Capacity *200* g.p.m.
(Make, type and size)


(b) Motor
(Type and horsepower)

14. Location of area irrigated or to be irrigated, or place of use if for purposes other than irrigation.

Township North or South	Range E. or W. of Willamette Meridian	Section	Forty-acre Tract	Number Acres To Be Irrigated	Date of Reclamation
5					
5	Range 4	27			
T 55	R 4W	27	SW $\frac{1}{4}$ of NW $\frac{1}{4}$	22.8	1953

15. If the ground water supply is supplemental to an existing water supply, identification of any application for a permit, permit, certificate or adjudicated right to appropriate water made or held by the registrant.

Township 5S Range 4W W.M.
North

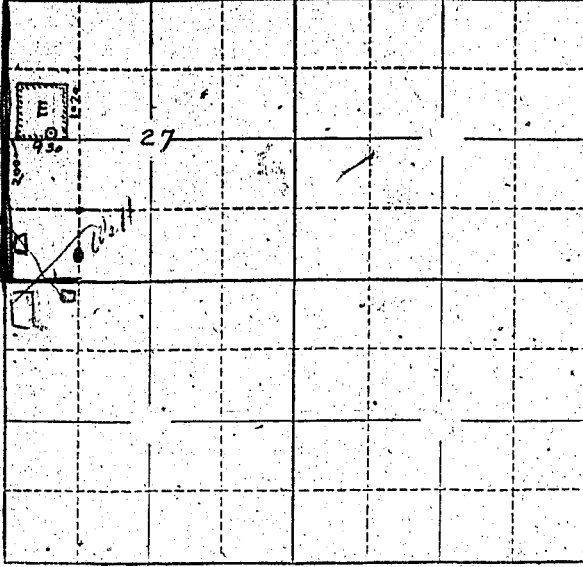

Locate well and acreage of irrigated land on plat.
Scale: 2" = 1 Mile

STATE OF OREGON }
County of Yamhill } ss.

I, Alf DeRaeve, being first duly sworn, do hereby certify that I have read the foregoing Registration Statement and that all of the items therein contained are true to the best of my knowledge and belief.

Alf DeRaeve
(Signature of Registrant)

Subscribed and sworn to before me this 24th day of February, 1956.

My commission expires February 10, 1960
Frank Chamber
(Notary Public)

(SEAL)

CERTIFICATE OF REGISTRATION

STATE OF OREGON }
County of Marion } ss.

This is to certify that the foregoing Registration Statement was received in the office of the State Engineer on the 12th day of March, 1957, at 8:00 o'clock A.M. and has been duly recorded in said office in Book No. 11 of Registration Statements on page GR-2437

~~Construction shall be completed by 1958, and the costs completely paid for as beneficial use by 1960~~

Witness my hand this 16th day of March, 1959

Lawrence A. Blanton
(State Engineer)

1500

By _____ (Deputy)

GR-2437