

Registration Statement

OF CLAIMANT OF RIGHT TO APPROPRIATE GROUND WATER

TO THE STATE ENGINEER OF OREGON:

I, A.O. Wright

of 16020 S.E. Harold Ave., Milwaukie, Oregon County of Clackamas

State of Oregon do hereby make application for a certificate of registration as evidence of a right to appropriate ground water.

1. Source from which water is withdrawn is Pump well
(Flowing well, pump well, infiltration trench, or tunnel)

2. Location is: Approximately 2 1/2 miles South of Milwaukie, Oregon
(Approximate distance and direction from nearest city or town)

and is more particularly described as follows:

(a) 1500 feet North & 125 feet East from SW Corner Section 7
(Give distance and bearing to corner of section or other legal subdivision)

being within NW 1/4 of SW 1/4 of Sec. 7, Twp. 2 S, Rge. 2 E
(Smallest legal subdivision) (T. or S.) (E. or W.)

or (b) within limits of recorded platted property, town or city:

in Lot 11, Block CCNCCRD 711 LIGHTS
(Name of plat or addition)

County of _____
(If within city or town, give name)

3. Construction Work was begun on 5/25/48; was completed on 5/31/48
(Date) (Date)

and the ground water claimed was first used for the purposes set out below on June 1948
(Date)

since which time the water has been used Continuously
(Continuously or intermittently)

from June 1948 to July 1958
(Date) (Date)

4. Quantity of water claimed and used is 50 gallons per minute; _____ acre feet per year.

5. Purpose or Purposes for which water is used Irrigation

(Domestic, irrigation, municipal, manufacturing, industrial, etc.)

6. Description of Well: Depth 203 feet. Type Drilled
(Dug or drilled)

diameter six inches. Elevation of ground at well site _____ feet, mean sea level.
(As near as known)

Depth to water table 18 feet.

7. Capacity of Well: 35 g.p.m. with no feet drawdown.
Bailer test

_____ g.p.m. with _____ feet drawdown.

Date of test May 31, 1948

If Flowing Well: Measured discharge _____ g.p.m. on _____
(Date)

Shut-in pressure at ground surface _____ lbs. per sq. in. on _____
(Date)

Water is controlled by _____
(Cap, valve, etc.)

8. Casing: (Give diameter, commercial specifications and depth below ground surface of each casing size.)

6 inch diameter Standard threaded and coupled from 0 to 77.5 feet
inch diameter from to feet
inch diameter from to feet
inch diameter from to feet

Describe and show depth of shoe, plug, adapter, liner or other details: no shoe

9. Perforated Casings or Screens:

None from to
(Number per foot and size of perforations, or describe screen)
from to
from to
from to

10. Log of Well: (Describe each stratum or formation clearly, indicate if water bearing, and give thickness and depth as indicated.)

MATERIAL	from	to	Thickness (Feet)	Depth to Bottom (Feet)
Yellow sandy clay	0	35	35	35
Decomposed rock	35	91	56	91
Hard grey rock	91	104	13	104
Black rock	104	139	35	139
Black and brown sandy rock	139	160	21	160
Hard grey rock	160	185	25	185
Brass rock	185	195	10	195
Hard grey rock	195	203	8	203

If log of well is not available, give name and address of driller.

11. Infiltration Trench: Covered or open

Dimensions: Length ft. Minimum depth ft. Maximum depth ft.

Bottom width ft. Discharge g.p.m. Date of test

12. Tunnel: Type of lining

Dimensions:
(Length, course, and cross sectional size)

Position of water bearing stratum with reference to portal of tunnel

Log of tunnel: (Preceding table for log of well may be used, if desired. Give footage from portal and character of materials, as pertinent.)

13. Pumping Equipment:

(a) Pump Peerless Capacity 50 g.p.m.
(Make, type and size)


(b) Motor Electric 3 H.P.
(Type and horsepower)

14. Location of area irrigated or to be irrigated, or place of use if for purposes other than irrigation.

Township North or South	Range E. or W. of Willamette Meridian	Section	Forty-acre Tract	Number Acres To Be Irrigated	Date of Reclamation
25	1E	12	NE 1/4 of SE 1/4	APPROX 1/3	1948
25	2E	7	NW 1/4 of SW 1/4	APPROX. 2/3	"
25	1E	12	NE 1/4 of SE 1/4	" 1/10	"
25	2E	7	NW 1/4 of SW 1/4	" 2/10	"
25	1E	12	SE 1/4 of SE 1/4	"	"
25	1E	12	NE 1/4 of SE 1/4	33 APPROX. 1/3	1948
25	2E	7	NW 1/4 of SW 1/4	1.66 " 12/3	"
25	1E	12	SE 1/4 of SE 1/4	.02 " 1/50	"
25	2E	7	SW 1/4 of SW 1/4	.05 " 1/20	"
25	1E	12	SE 1/4 of SE 1/4	1.1 " 1 1/10	"
25	2E	7	SW 1/4 of SW 1/4	.9 " 9/10	"
				3.97	
				APPROX 4 ACRES	
				3.97 Ac	

15. If the ground water supply is supplemental to an existing water supply, identification of any application for a permit, permit, certificate or adjudicated right to appropriate water made or held by the registrant.

Township 2S Range 2E, W.M.
North

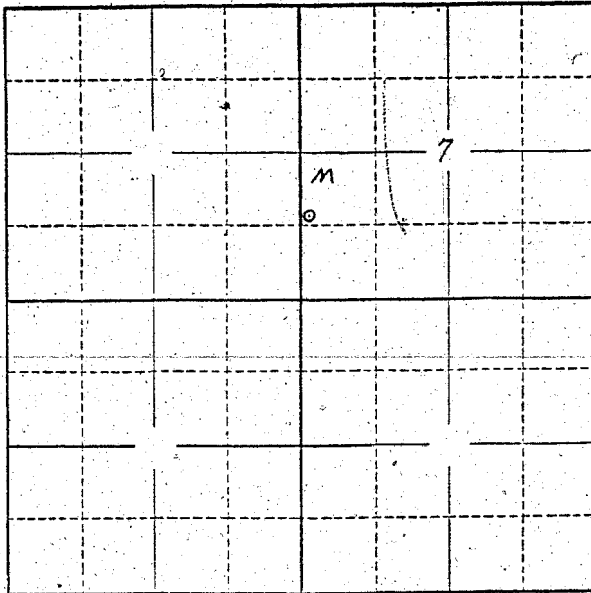

Locate well and acreage of irrigated land on plat.
Scale: 2" = 1 Mile

STATE OF OREGON

County of Clackamas } ss.

I, Arthur C. Wright, being first duly sworn, do hereby certify that I have read the foregoing Registration Statement and that all of the items therein contained are true to the best of my knowledge and belief.

Arthur C. Wright
(Signature of Registrant)

Subscribed and sworn to before me this 30th day of July, 19 58

My commission expires Dec. 11, 1959

Josephine Beck
(Notary Public)

(SEAL)

CERTIFICATE OF REGISTRATION

STATE OF OREGON }
County of Marion } ss.

This is to certify that the foregoing Registration Statement was received in the office of the State Engineer on the 4th day of August, 19 58, at 8:00 o'clock A. M. and has been duly recorded in said office in Book No. 15 of Registration Statements on page GR-3577

Witness my hand this 15th day of September, 19 59

Lewis A. Stanley
(State Engineer)

\$15.00

By _____
(Deputy)

GR 3577