

Registration Statement

OF CLAIMANT OF RIGHT TO APPROPRIATE GROUND WATER

TO THE STATE ENGINEER OF OREGON:

I, Mrs. Lorene Sails Higgins
 of 1209 S. W. Sixth Avenue, Portland County of Multnomah
(Mailing address)
 State of Oregon do hereby make application for a certificate of registration as evidence
 of a right to appropriate ground water.

1. Source from which water is withdrawn is Pump Well
(Flowing well, pump well, infiltration trench, or tunnel)

2. Location is: One mile west of main street, Gresham.
(Approximate distance and direction from nearest city or town)

and is more particularly described as follows:

(a) Well is 200 feet East and 100 North of
(Give distance and bearing to corner of section or other legal subdivision)
the SW Cor. of SE 1/4 of Sec. 4, Twp. 1 S, Rge. 3 E
(Smallest legal subdivision) (N. or S.) (E. or W.)
 being within

or (b) within limits of recorded platted property, town or city:

in Lot _____, Block _____ of _____
(Name of plat or addition)
 _____ County of _____
(If within city or town, give name)

3. Construction Work was begun on July 15, 1951; was completed on June 1, 1951
(Date) (Date)

and the ground water claimed was first used for the purposes set out below on June 1951
(Date)

since which time the water has been used continuously
(Continuously or intermittently)

from June, 1951 to July, 1951
(Date) (Date)

4. Quantity of water claimed and used is 30 gallons per minute; _____ acre
 feet per year.

5. Purpose or Purposes for which water is used (exempt) Domestic & Irrigation
(Domestic, irrigation, municipal, manufacturing, industrial, etc.)

6. Description of Well: Depth 14 1/2 feet. Type Drilled
(Dug or drilled)

diameter 6 inches. Elevation of ground at well site Approx. 350 feet, mean sea level.
(As near as known)

Depth to water table 32 feet.

7. Capacity of Well: 30 g.p.m. with 50 feet drawdown.
 _____ g.p.m. with _____ feet drawdown.

Date of test June 1, 1951


If Flowing Well: Measured discharge _____ g.p.m. on _____
(Date)

Shut-in pressure at ground surface _____ lbs. per sq. in. on _____
(Date)

Water is controlled by _____
(Cap, valve, etc.)

Sec. 4

Township 15 Range 3E, W.M.
North

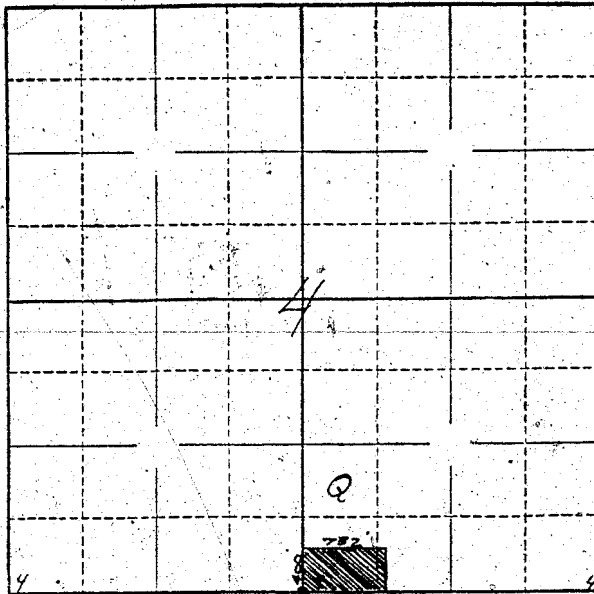

Locate well and acreage of irrigated land on plat.

Scale: 3" = 1 Mile
4"

STATE OF OREGON

County of Multnomah } ss.

I, Mrs. Lorene Sails Higgins, being first duly sworn, do hereby certify that I have read the foregoing Registration Statement and that all of the items therein contained are true to the best of my knowledge and belief.

Mrs. Lorene Sails Higgins
(Signature of Registrant)

Subscribed and sworn to before me this 30th day of July, 1958.

My commission expires April 21, 1961. *Esther M. Nagelbauer*
(Notary Public)

(SEAL)

CERTIFICATE OF REGISTRATION

STATE OF OREGON } ss.
County of Marion

This is to certify that the foregoing Registration Statement was received in the office of the State Engineer on the 1st day of August, 1958, at 2:00 o'clock A.M. and has been duly recorded in said office in Book No. 15 of Registration Statements on page GR-3578.

Witness my hand this 15th day of September, 1959.

Lewis A. Stanley
(State Engineer)

By _____ (Deputy)

\$15.00

GR. 3578