

RECEIVED

FEB 25 1957
STATE ENGINEER
SALEM, OREGON

REGISTRATION NO. GR-396
CERTIFICATE NO. 381

Registration Statement

OF CLAIMANT OF RIGHT TO APPROPRIATE GROUND WATER

(Under Chapter 708, Oregon Laws 1955.)

TO THE STATE ENGINEER OF OREGON:

I, John Nakai
of Rt. #2 Box 458, Cornelius County of Washington
State of Oregon, do hereby make application for a certificate of registration as evidence
of a right to appropriate ground water.

1. Source from which water is withdrawn is Pump Well
(Flowing well, pump well, infiltration trench, or tunnel)

2. Location is: 2 1/2 miles south of Forest Grove, Oregon
(Approximate distance and direction from nearest city or town)

and is more particularly described as follows:

(a) 320 ft. North, and 1540 ft. East; or N78°16'E 1572.9 ft. from the West 1/4 Cor. Sec 17
(Give distance and bearing to corner of section or other legal subdivision)

being within SE 1/4 NW 1/4 of Sec. 17, Twp. 1S, Rge. 3W
(Smallest legal subdivision) (N. or S.) (E. or W.)

or (b) within limits of recorded platted property, town or city:

in Lot _____, Block _____ of _____
(Name of plat or addition)

County of _____
(If within city or town, give name)

3. Construction Work was begun on June 1954; was completed on July 1954
(Date) (Date)

and the ground water claim was first used for the purposes set out below on May 1957
(Date)

since which time the water has been used ** See footnote.
(Continuously or intermittently)

from _____ to _____
(Date) (Date)

4. Quantity of water claimed and used is 62 gallons per minute; _____ acre
feet per year.

5. Purpose or Purposes for which water is used Irrigation

(Domestic, irrigation, municipal, manufacturing, industrial, etc.)

6. Description of Well: Depth 250 feet. Type Drilled
(Dug or drilled)

diameter 6 inches. Elevation of ground at well site 300 feet, mean sea level.
(As near as known)

Depth to water table 80 feet.

7. Capacity of Well: 62-65 g.p.m. with ? feet drawdown.

_____ g.p.m. with _____ feet drawdown.

Date of test July 6th, 1954, and Aug 2, 1954


If Flowing Well: Measured discharge _____ g.p.m. on _____
(Date)

Shut-in pressure at ground surface _____ lbs. per sq. in. on _____
(Date)

Water is controlled by _____
(Cap, valve, etc.)

**The well was drilled in 1954, but the pump was not installed until October 1956.

Township T1S Range R3W W.M.
North

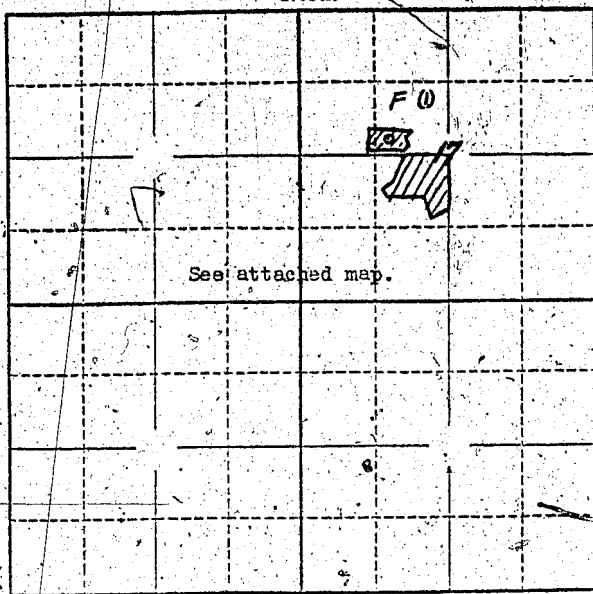

Locate well and acreage of irrigated land on plat.
Scale: 2" = 1 Mile

STATE OF OREGON

County of Washington } ss.

I, John Nekai, being first duly sworn, do hereby certify that I have read the foregoing Registration Statement and that all of the items therein contained are true to the best of my knowledge and belief.

John Nekai
(Signature of Registrant)

Subscribed and sworn to before me this 21st day of February, 1957.

My commission expires February 9, 1959.
Sala E. Christensen
(Notary Public)

(SEAL)

CERTIFICATE OF REGISTRATION

STATE OF OREGON

County of Marion } ss.

This is to certify that the foregoing Registration Statement was received in the office of the State Engineer on the 15th day of March, 1957 at 8:00 o'clock A.M. and has been duly recorded in said office in Book No. D3 of Registration Statements on page GR-381 C

~~Construction shall be completed by x-x-x-x-x-x-x-x-19-x-x and the water completely applied to x-x-x-x-x-x-x-x-19-x-x~~

Witness my hand this 23rd day of May, 1957.

Louis A. Stanley
(State Engineer)

By _____ (Deputy)