

RECEIVED
JUL 8 0 1958

Registration No. GR-3960

Certificate No. GR-4053

STATE ENGINEER
SALARY

Registration Statement

RECEIVED
JUL 10 1958

OF CLAIMANT OF RIGHT TO APPROPRIATE GROUND WATER

TO THE STATE ENGINEER OF OREGON:

I, Richard E Dye

of Route 3, Box 257 Canby County of Clackamas

State of Oregon, do hereby make application for a certificate of registration as evidence of a right to appropriate ground water.

1. Source from which water is withdrawn is pump well
(Flowing well, pump well, infiltration trench, or tunnel)

2. Location is: 2 miles S.W. of Canby, Oregon
(Approximate distance and direction from nearest city or town)

and is more particularly described as follows:

(a) 100 feet north & 180 feet east from NW corner Section 5
(Give distance and bearing to corner of section or other legal subdivision)

being within SW 1/4 of NW 1/4 of Sec. 5, Twp. 4S, Rge. 1E
(Smallest legal subdivision) (T. or S.) (R. or W.)

or (b) within limits of recorded platted property, town or city: Barlow Tax lot 1

in Lot 1, Block _____ of Barlow
(Name of plat or addition)

County of Clackamas
(If within city or town, give name)

3. Construction Work was begun on _____ well was in operation when property purchased in 1954
(Date) (Date)

and the ground water claimed was first used for the purposes set out below on 1954
(Date)

since which time the water has been used intermittently
(Continuously or intermittently)

from May 1 to Sept 1
(Date) (Date)

4. Quantity of water claimed and used is 100 gallons per minute; _____ acre feet per year.

5. Purpose or Purposes for which water is used irrigation

(Domestic, irrigation, municipal, manufacturing, industrial, etc.)

6. Description of Well: Depth 87 feet. Type drilled

(Dug or drilled)

diameter 12 inches. Elevation of ground at well site _____ feet, mean sea level.

(As near as known)

Depth to water table 9 feet.

7. Capacity of Well: 100 g.p.m. with 22 feet drawdown.

_____ g.p.m. with _____ feet drawdown.


Date of test _____

If Flowing Well: Measured discharge _____ g.p.m. on _____
(Date)

Shut-in pressure at ground surface _____ lbs. per sq. in. on _____
(Date)

Water is controlled by _____
(Cap. valve, etc.)

45 1E
Township 22N Range 2E W.M.
North

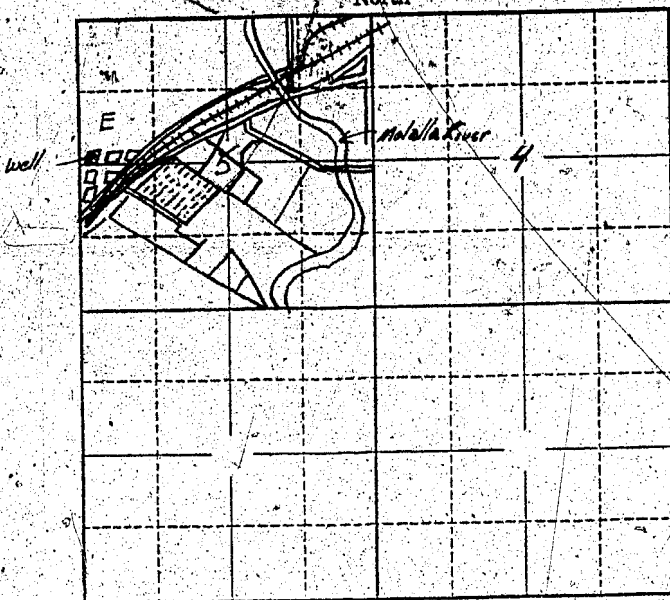

Locate well and acreage of irrigated land on plat.
Scale: 2" = 1 Mile

STATE OF OREGON

County of Clackamas } ss.

I, Richard E Dye, being first duly sworn, do hereby certify that I have read the foregoing Registration Statement and that all of the items therein contained are true to the best of my knowledge and belief.

Richard E Dye
(Signature of Registrant)

Subscribed and sworn to before me this 28 day of July, 1958

My commission expires COM: *Helen Dye*
(Notary Public)

(SEAL)

CERTIFICATE OF REGISTRATION

STATE OF OREGON

County of Marion } ss.

This is to certify that the foregoing Registration Statement was received in the office of the State Engineer on the 4th day of August, 1958, at 8:00 o'clock A.M. and has been duly recorded in said office in Book No. 17 of Registration Statements on page GR 4053

Witness my hand this 16th day of May, 1960

Lewis A. Stanley
(State Engineer)

By _____ (Deputy)

\$15.00

GR 4053