RECEIVED
STATE ENGINEER
SALEM, OREGON

REGISTRATION NO. GR-392
CERTIFICATE NO. GR 382

Registration Statement

OF CLAIMANT OF RIGHT TO APPROPRIATE GROUND WATER

(Under Chapter 708, Oregon Laws 1955.)

TO THE STATE ENGINEER OF OREGON:

I, Leon Hilton,

of West Stayton County of Marion

State of Oregon, do hereby make application for a certificate of registration as evidence of a right to appropriate ground water.

1. **Source** from which water is withdrawn is Pump well (Flowing well, pump well, infiltration trench, or tunnel)

2. **Location** is: 4 miles South west of Stayton (Approximate distance and direction from nearest city or town);

and is more particularly described as follows:

(a) 1735 feet North 22° 05' East of SW corner Section 18 (Give distance and bearing to corner of section or other legal subdivision)

being within NW¼ of SW¼ (Smallest legal subdivision) of Sec. 18, Twp. 9S (N. or S.), Rge. 1 W (E. or W.)

or (b) within limits of recorded platted property, town or city:

in Lot ..... Block ..... of ..... (Name of plat or addition)

..... (If within city or town, give name) County of .....

3. **Construction Work** was begun on 1941 (Date); was completed on 1941 (Date)

and the ground water claimed was first used for the purposes set out below on 1941 (Date),

since which time the water has been used Continously (Continuously or intermittently)

from May 15 (Date) to Octobe r 1 (Date)

4. **Quantity** of water claimed and used is 132 gallons per minute; 15 acre feet per year.

5. **Purpose or Purposes** for which water is used Irrigation

..... (Domestic, irrigation, municipal, manufacturing, industrial, etc.)

6. **Description of Well:** Depth 22 feet. Type Drilled (Dug or drilled)

diameter 10 inches. Elevation of ground at well site 385 (As near as known) feet, mean sea level.

Depth to water table varies o to 10 1956 feet.

7. **Capacity of Well:** 132 g.p.m. with 12 feet drawdown.

..... g.p.m. with ..... feet drawdown.

Date of test Any irrigation day

If Flowing Well: Measured discharge ..... g.p.m. on ..... (Date)

Shut-in pressure at ground surface ..... lbs. per sq. in. on ..... (Date)

Water is controlled by ..... (Cap, valve, etc.)

8. **Casing:** (Give diameter, commercial specifications and depth below ground surface of each casing size.)

10 inch diameter from 0 to 22 feet

inch diameter from to feet

inch diameter from to feet

inch diameter from to feet

Describe and show depth of shoe, plug, adapter, liner or other details:

9. **Perforated Casings or Screens:**

Perforated (Number per foot and size of perforations, or describe screen) from 10' to 22'

from to

from to

from to

10. **Log of Well:** (Describe each stratum or formation clearly, indicate if water bearing, and give thickness and depth as indicated.)

MATERIAL	Thickness (Feet)	Depth to Bottom (Feet)
Heavy gravel and sand		

382 A

If log of well is not available, give name and address of driller. ?

11. **Infiltration Trench:** Covered or open

Dimensions: Length ft. Minimum depth ft. Maximum depth ft.

Bottom width ft. Discharge g.p.m. Date of test

12. **Tunnel:** Type of lining

Dimensions:
(Length, course, and cross sectional size)

Position of water bearing stratum with reference to portal of tunnel

Log of tunnel: (Preceding table for log of well may be used, if desired. Give footage from portal and character of materials, as pertinent.)

13. **Pumping Equipment:**

(a) Pump centrifugal (Make, type and size) Capacity 132 gal. plus g.p.m.

(b) Motor 3 ph. electric 7½ H. P. (Type and horsepower)

14. Location of area irrigated or to be irrigated, or place of use if for purposes other than irrigation.

Township North or South	Range E. or W. of Willamette Meridian	Section	Forty-acre Tract	Number Acres To Be Irrigated	Date of Reclamation
9 S	1 W	18	NE of SW	0.04	1941
9 S	1 W	18	NW of SW	5.18	"
9 S	1 W	18	SW of SW	4.61	"
9 S	1 W	18	SE of SW	0.55	"
				10.68	

15. If the ground water supply is supplemental to an existing water supply, identification of any application for a permit, permit, certificate or adjudicated right to appropriate water made or held by the registrant.

Township 2 S. Range 1 W., W.M.

North

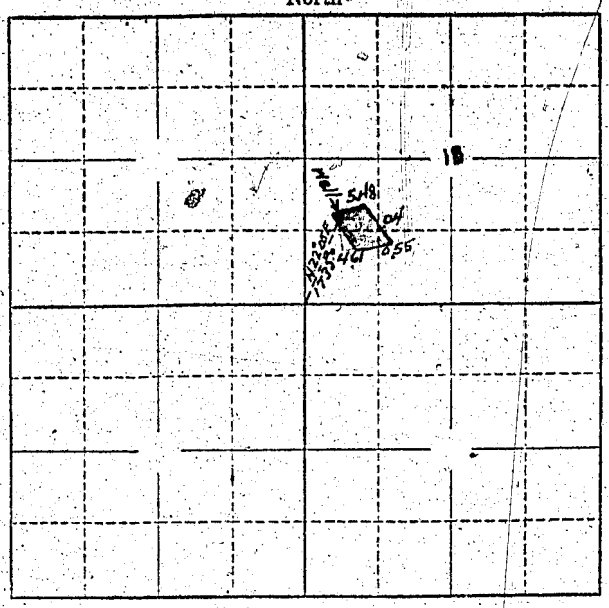

Locate well and acreage of irrigated land on plat.

Scale: 2" = 1 Mile

STATE OF OREGON
County of Marion } ss.

I, Leon Hilton, being first duly sworn, do hereby certify that I have read the foregoing Registration Statement and that all of the items therein contained are true to the best of my knowledge and belief.

Leon Hilton
(Signature of Registrant)

Subscribed and sworn to before me this 12 day of March, 19 57.

My commission expires 8/21/58

Walter H. Lee
(Notary Public)

(SEAL)

CERTIFICATE OF REGISTRATION

STATE OF OREGON
County of Marion } ss.

This is to certify that the foregoing Registration Statement was received in the office of the State Engineer on the 15th day of March, 19 57, at 8:00 o'clock A. M. and has been duly recorded in said office in Book No. 3 of Registration Statements on page GR-382 C

~~Construction shall be completed by xxxxxxxxxx and the water completely applied to beneficial use by xxxxxxxxxx~~

Witness my hand this 23rd day of May, 19 57.

Lewis A. Stanley
(State Engineer)

$15.00

By
(Deputy)

382 C