

RECEIVED  
AUG 1 1958  
STATE ENGINEER  
OREGON

REGISTRATION NO. GR-3970  
CERTIFICATE NO. GR-4071

### Registration Statement

RECEIVED  
APR 18 1960  
STATE ENGINEER  
OREGON

### OREGON OF CLAIMANT OF RIGHT TO APPROPRIATE GROUND WATER

(Under Chapter 708, Oregon Laws 1955.)

TO THE STATE ENGINEER OF OREGON:

I, William Thomas Mills and/or Neva I Mills  
of Route 1 Box 392 Springfield County of Lane

State of Oregon, do hereby make application for a certificate of registration as evidence of a right to appropriate ground water.

1. Source from which water is withdrawn is rump well  
(Flowing well, pump well, infiltration trench, or tunnel)
2. Location is: Southeast 1 1/2 miles  
(Approximate distance and direction from nearest city or town)

and is particularly described as follows:

(a) appr 1113 ft. s. of intersection corners of section 31-32-6-5 thence west appr 300ft.  
(Give distance and bearing to corner of section or other legal subdivision)  
being within Lot 3 NE 1/4 + NE 1/4 of Sec. 5-6, Twp. 18 S, Rge. 2W, ME  
(Smallest legal subdivision) (N. or S.) (E. or W.)

or (b) within limits of recorded platted property, town or city:

in Lot \_\_\_\_\_, Block \_\_\_\_\_ of \_\_\_\_\_  
(Name of plat or addition)  
County of Lane  
(If within city or town, give name)

3. Construction Work was begun on 51 or 52; was completed on same year - 1952  
(Date) (Date)

and the ground water claimed was first used for the purposes set out below on same - 1952  
(Date)

since which time the water has been used continuously  
(Continuously or Intermittently)

from 1952 to 1958  
(Date) (Date)

4. Quantity of water claimed and used is 150 gallons per minute; \_\_\_\_\_ acre feet per year.

5. Purpose or Purposes for which water is used irrigation

(Domestic, irrigation, municipal, manufacturing, industrial, etc.)

6. Description of Well: Depth 38 feet. Type drilled  
(Dug or drilled)

diameter 5 1/2 inches. Elevation of ground at well site app 500 feet, mean sea level.  
(As near as known)

Depth to water table 30 feet.

7. Capacity of Well: \_\_\_\_\_ g.p.m. with \_\_\_\_\_ feet drawdown. inadequate

\_\_\_\_\_ g.p.m. with \_\_\_\_\_ feet drawdown.

Date of test \_\_\_\_\_

If Flowing Well: Measured discharge \_\_\_\_\_ g.p.m. on \_\_\_\_\_  
(Date)

Shut-in pressure at ground surface \_\_\_\_\_ lbs. per sq. in. on \_\_\_\_\_  
(Date)

Water is controlled by \_\_\_\_\_  
(Cap, valve, etc.)

8. Casing: (Give diameter, commercial specifications and depth below ground surface of each casing size.)

5" inch diameter ..... from ..... to 30' feet  
 ..... inch diameter ..... from ..... to ..... feet  
 ..... inch diameter ..... from ..... to ..... feet  
 ..... inch diameter ..... from ..... to ..... feet

Describe and show depth of shoe, plug, adapter, liner or other details: .....

9. Perforated Casings or Screens:

18 3/8x 4 from 31 to 38  
(Number per foot and size of perforations, or describe screen)  
 ..... from ..... to .....  
 ..... from ..... to .....  
 ..... from ..... to .....

10. Log of Well: (Describe each stratum or formation clearly, indicate if water bearing, and give thickness and depth as indicated.)

MATERIAL	Thickness (Feet)	Depth to Bottom (Feet)
top soil	6'	
sand & gravel	6'	38'

If log of well is not available, give name and address of driller:

Carter Well Drillers 325 S. 2nd St., Springfield Oregon.

11. Infiltration Trench: Covered or open

Dimensions: Length \_\_\_\_\_ ft. Minimum depth \_\_\_\_\_ ft. Maximum depth \_\_\_\_\_ ft.

Bottom width \_\_\_\_\_ ft. Discharge \_\_\_\_\_ g.p.m. Date of test \_\_\_\_\_

12. Tunnel: Type of lining

Dimensions: \_\_\_\_\_  
(Length, course, and cross sectional size)

Position of water bearing stratum with reference to portal of tunnel

Log of tunnel: (Preceding table for log of well may be used, if desired. Give footage from portal and character of materials, as pertinent.)

13. Pumping Equipment:

(a) Pump 5 H Jaquzzi centrifical Capacity 100 g.p.m.  
(Make, type and size)


(b) Motor Electric 5 Horsepower  
(Type and horsepower)

14. Location of area irrigated or to be irrigated, or place of use if for purposes other than irrigation.

Township North or South	Range E or W. of Willamette Meridian	Section	Forty-acre Tract	Number Acres To Be Irrigated	Date of Reclamation
T 18S	2W	6	NE $\frac{1}{4}$ of NE $\frac{1}{4}$	9.98	1952
			(See map attached)		

15. If the ground water supply is supplemental to an existing water supply identification of any application for a permit, permit, certificate or adjudicated right to appropriate water made or held by the registrant.

Township 12.5 Range 2.W, W.M.  
North

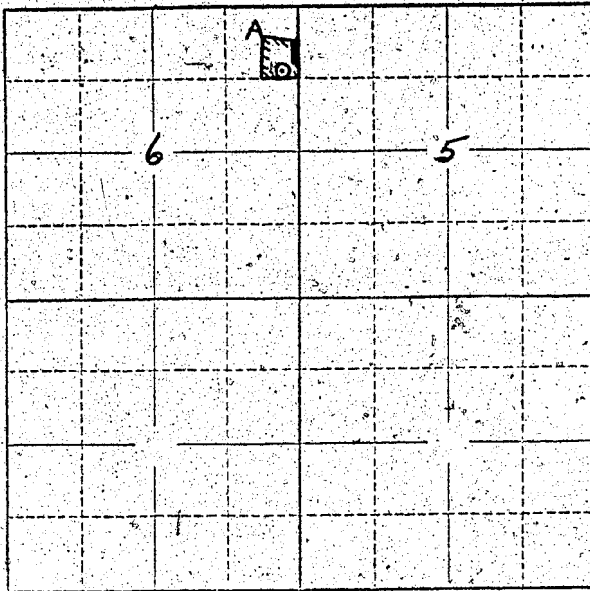

Locate well and acreage of irrigated land on plat.  
Scale: 2" = 1 Mile.

STATE OF OREGON

County of Tillamook } ss.

I, \_\_\_\_\_, being first duly sworn, do hereby certify that I have read the foregoing Registration Statement and that all of the items therein contained are true to the best of my knowledge and belief.

Mrs. J. Mills  
(Signature of Registrant)

Subscribed and sworn to before me this 30 day of July, 1953

My commission expires 4-19-62 Ever Stanford  
(Notary Public)

(SEAL)

**CERTIFICATE OF REGISTRATION**

STATE OF OREGON } ss.  
County of Marion

This is to certify that the foregoing Registration Statement was received in the office of the State Engineer on the 4 day of August, 1958, at 8.00 o'clock A.M. and has been duly recorded in said office in Book No. 17 of Registration Statements on page GR-4071

~~xx Construction shall be completed by \_\_\_\_\_ 19\_\_\_\_ and the order completely applied for  
before \_\_\_\_\_~~

Witness my hand this 16<sup>th</sup> day of May, 1960

Lewis A. Stanley  
(State Engineer)

By \_\_\_\_\_ (Deputy)

GR-4071

#15.00