

# Registration Statement

## OF CLAIMANT OF RIGHT TO APPROPRIATE GROUND WATER

WELL NO. 1

TO THE STATE ENGINEER OF OREGON:

I, J. IRA McNUTT

of 827 Mill St. Springfield County of Lane  
(Mailing address)

State of Oregon do hereby make application for a certificate of registration as evidence of a right to appropriate ground water.

1. Source from which water is withdrawn is 12" cased drilled pump well #1  
(Flowing well, pump well, infiltration trench, or tunnel)

2. Location is: 1 mile South of Harrisburg  
(Approximate distance and direction from nearest city or town)

and is more particularly described as follows:

(a) 880' North and 1010' East of Southwest corner Section 15, T15S, R4W  
(Give distance and bearing to corner of section or other legal subdivision)

being within S.W. 1/4, S.W. 1/4 of Sec. 15, Twp. 15 South, Rge. 4 West  
(Smallest legal subdivision) (N. or S.) (E. or W.)

or (b) within limits of recorded platted property, town or city:

in Lot \_\_\_\_\_, Block \_\_\_\_\_ of \_\_\_\_\_  
(Name of plat or addition)

County of Linn  
(If within city or town, give name)

3. Construction Work was begun on 1950; was completed on 1950  
(Date) (Date)

and the ground water claimed was first used for the purposes set out below on 1950  
(Date)

since which time the water has been used continuously  
(Continuously or intermittently)

from 1950 to 1958  
(Date) (Date)

4. Quantity of water claimed and used is 900 gallons per minute; 97 acre feet per year.

5. Purpose or Purposes for which water is used irrigation  
(Domestic, irrigation, municipal, manufacturing, industrial, etc.)

6. Description of Well: Depth 35 feet. Type drilled  
(Dug or drilled)

diameter 12 inches. Elevation of ground at well site 300 feet, mean sea level.  
(As near as known)

Depth to water table 10 feet.

7. Capacity of Well: 900 g.p.m. with 3 feet drawdown.

\_\_\_\_\_ g.p.m. with \_\_\_\_\_ feet drawdown.

Date of test estimated

If Flowing Well: Measured discharge \_\_\_\_\_ g.p.m. on \_\_\_\_\_  
(Date)


Shut-in pressure at ground surface \_\_\_\_\_ lbs. per sq. in. on \_\_\_\_\_  
(Date)

Water is controlled by \_\_\_\_\_  
(Cap, valve, etc.)





Township 15.5 Range 4W, W.M.  
North

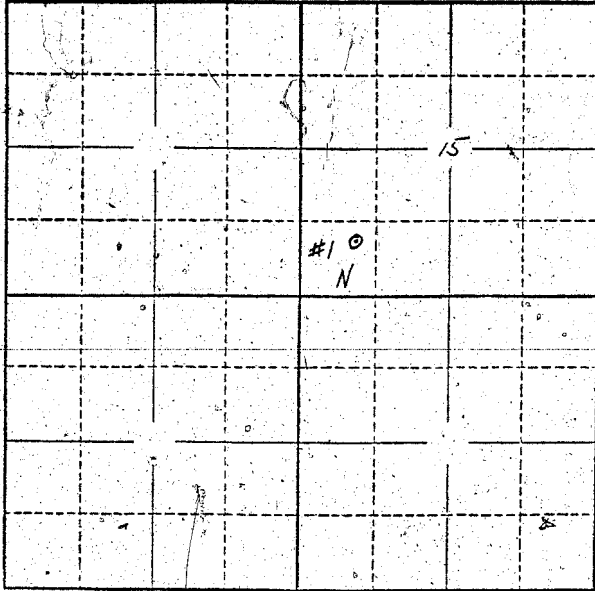

Locate well and acreage of irrigated land on plat.

Scale: 2" = 1-Mile

STATE OF OREGON



(State of Oregon)

Subscribed and sworn to before me this 15th day of July, 1958.

My commission expires May 27, 1962 Margaret A. Williams  
(Notary Public)

(SEAL)

**CERTIFICATE OF REGISTRATION**

STATE OF OREGON

County of Marion } ss.

This is to certify that the foregoing Registration Statement was received in the office of the State Engineer on the 1st day of August, 1958, at 8:00 o'clock A. M. and has been duly recorded in said office in Book No. 15 of Registration Statements on page GR 3586

Witness my hand this 15th day of September, 1959.

Laura A. Stanley  
(State Engineer)

By \_\_\_\_\_ (Deputy)

GR 3586

#16-35