

AT HOP YARD #3

Registration No. GR 3977

Certificate No. GR 3592

# Registration Statement

## OF CLAIMANT OF RIGHT TO APPROPRIATE GROUND WATER

TO THE STATE ENGINEER OF OREGON:

I, V. O. WEATHERS

of RT1 Box 57 INDEPENDENCE County of POLK

State of OREGON do hereby make application for a certificate of registration as evidence of a right to appropriate ground water.

1. Source from which water is withdrawn is PUMP WELL  
(Flowing well, pump well, infiltration trench, or tunnel)

2. Location is: 7 MI SOUTH EAST OF INDEPENDENCE  
(Approximate distance and direction from nearest city or town)

and is more particularly described as follows:

(a) 20.16 chains N 20° 37' W from S.E. Corner Section 1  
(Give distance and bearing to corner of section or other legal subdivision)

being within S. N.E. 1/4 - S.E. 1/4 of Sec. 1, Twp. 9 S, Rge. 4 W  
(Smallest legal subdivision) (N. or S.) (E. or W.)

or (b) within limits of recorded platted property, town or city:

in Lot \_\_\_\_\_, Block \_\_\_\_\_ of \_\_\_\_\_  
(Name of plat or addition)

County of Polk  
(If within city or town, give name)

3. Construction Work was begun on 1954; was completed on 1954  
(Date) (Date)

and the ground water claimed was first used for the purposes set out below on 1954  
(Date)

since which time the water has been used intermittently during season  
(Continuously or intermittently)

from 1954 to 1958  
(Date) (Date)

4. Quantity of water claimed and used is 500 gallons per minute; \_\_\_\_\_ acre feet per year.

5. Purpose or Purposes for which water is used IRRIGATION

(Domestic, irrigation, municipal, manufacturing, industrial, etc.)

6. Description of Well: Depth 32 feet. Type DRILLED  
(Dug or drilled)

diameter 10 inches. Elevation of ground at well site \_\_\_\_\_ feet, mean sea level.  
(As near as known)

Depth to water table 14 feet.

7. Capacity of Well: 500 g.p.m. with 4 feet drawdown,

\_\_\_\_\_ g.p.m. with \_\_\_\_\_ feet drawdown.

Date of test July 57

If Flowing Well: Measured discharge \_\_\_\_\_ g.p.m. on \_\_\_\_\_  
(Date)

Shut-in pressure at ground surface \_\_\_\_\_ lbs. per sq. in. on \_\_\_\_\_  
(Date)


Water is controlled by \_\_\_\_\_  
(Cap, valve, etc.)





Township 9S Range 4W W.M.

North

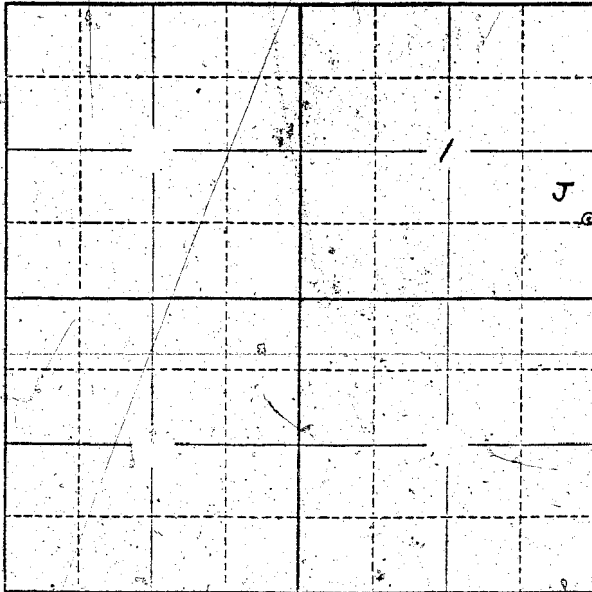

Locate well and acreage of irrigated land on plat.

Scale: 2" = 1 Mile

STATE OF OREGON

County of Marion

} ss.

I, V. O. Weathers, being first duly sworn, do hereby certify that I have read the foregoing Registration Statement and that all of the items therein contained are true to the best of my knowledge and belief.

V. O. Weathers  
(Signature of Registrant)

Subscribed and sworn to before me this 4th day of August 19 58

My commission expires My Commission Expires May. 25 1959

[Signature]  
(Notary Public)

(SEAL)

**CERTIFICATE OF REGISTRATION**

STATE OF OREGON

County of Marion

} ss.

This is to certify that the foregoing Registration Statement was received in the office of the State Engineer on the 4 day of August, 1958, at 11:45 o'clock A. M. and has been duly recorded in said office in Book No. 15 of Registration Statements on page GR 3592.

Witness my hand this 15th day of September, 1959

Laura A. Stanley  
(State Engineer)

By \_\_\_\_\_  
(Deputy)

# 22-35

GR 3592